


Give All Information Completely
Make Required Affidavit
Mail or Deliver Report to:
Conservation Division
State Corporation Commission
212 North Market, Insurance Bldg.
Wichita, Kansas

WELL PLUGGING RECORD

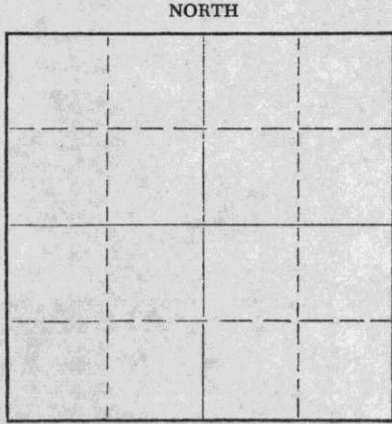

Locate well correctly on above
Section Plat

Barber County. Sec. 18 Twp. 31S Rge. (E) 10 (W)
Location as "NE/CNW/SW" or footage from lines C NW SW
Lease Owner W. J. COPPINGER, et.al.
Lease Name INSLEE Well No. 1
Office Address 717 Union Nat'l Bldg., Wichita, Kansas
Character of Well (completed as Oil, Gas or Dry Hole) dry hole
Date well completed 5-12-63 19
Application for plugging filed 5-12-63 19
Application for plugging approved 5-12-63 19
Plugging commenced 5-12-63 19
Plugging completed 5-12-63 19
Reason for abandonment of well or producing formation dry hole

If a producing well is abandoned, date of last production _____ 19
Was permission obtained from the Conservation Division or its agents before plugging was commenced? yes

Name of Conservation Agent who supervised plugging of this well Herman E. Justus
Producing formation _____ Depth to top _____ Bottom _____ Total Depth of Well 4556 Feet
Show depth and thickness of all water, oil and gas formations.

OIL, GAS OR WATER RECORDS

CASING RECORD

FORMATION	CONTENT	FROM	TO	SIZE	PUT IN	PULLED OUT
				8-5/8"	235'	-0-

Describe in detail the manner in which the well was plugged, indicating where the mud fluid was placed and the method or methods used in introducing it into the hole. If cement or other plugs were used, state the character of same and depth placed, from _____ feet to _____ feet for each plug set.
Mud to 180' - 1/2 sx. hulls, plug - 20 sx. cement
Mud to 40' - 1/2 sx. hulls, plug - 10 sx. cement
Plug rat hole w/2 sx. cement

RECEIVED
STATE CORPORATION COMMISSION

MAY 14 1963

CONSERVATION DIVISION
Wichita, Kansas

(If additional description is necessary, use BACK of this sheet)

Name of Plugging Contractor K & E DRILLING, INC.
Address 719 Union Center Building, Wichita 2, Kansas

STATE OF KANSAS, COUNTY OF SEDGWICK, ss.
H.L. Wilson of K & E Drlg., Inc. (employer or owner) or (owner or operator) of the above described

well being first duly sworn on oath, says: That I have knowledge of the facts, statements, and matters herein contained and the log of the above-described well as filed and that the same are true and correct. So help me God.

(Signature) H.L. Wilson
H. L. Wilson
719 Union Center, Wichita 2, Kansas
(Address)

SUBSCRIBED AND SWORN TO before me this 13th day of May 1963

My commission expires August 30, 1965
Julene M. Bannon
Julene M. Bannon Notary Public.



DRILLER'S WELL LOG

OPERATOR: W. J. COPPINGER, et.al.
717 Union National Building
Wichita, Kansas

WELL NAME: #1 INSLEE

LOCATION: C NW SW, Sec. 18-31S-10W
Barber County, Kansas

CONTRACTOR: **K & E DRILLING, INC.**
719 UNION CENTER BLDG.
WICHITA, KANSAS

COMMENCED: 5-2-63

CASING RECORD: 8-5/8" @ 235' w/175 sx.

COMPLETED: 5-12-63

ROTARY TOTAL DEPTH: 4556'

ELEVATION: 1725' D.F.

1728' K.B.

PRODUCTION: D & A

FORMATION RECORD

Depths shown indicate bottom of formations encountered.

Sand	100
Red Bed	887
Red Bed, Shale & Shells	1460
Shale & Shells	1705
Lime & Shale	2085
Lime	2260
Shale & Lime	2500
Lime & Shale	3608
Lime	3800
Lime & Sand	3925
Lime	4556 RTD

RECEIVED
STATE CORPORATION COMMISSION

MAY 14 1963

CONSERVATION DIVISION
Wichita, Kansas

CERTIFICATION

State of KANSAS }
County of SEDGWICK } ss:

I, H. L. Wilson, of K&E DRILLING, INC., upon oath state
that the above and foregoing is a true and correct copy of the Driller's Log of the above named well.

H. L. Wilson

Subscribed and sworn to before me this 13th day of May 1963.

Julene M. Bannon

Notary Public.

My Commission expires: August 30, 1965.

K & E DRILLING, INC.



Rotary Drilling Contractors