

WELL PLUGGING RECORD

Give All Information Completely
Make Required Affidavit
Mail or Deliver Report to:
Conservation Division
State Corporation Commission
211 No. Broadway
Wichita, Kansas

Barber County, Sec. 2 Twp. 30S Rge. (X) 14 (W)

Location as "NE/CNWxSWx" or footage from lines NW NW SE

Lease Owner Jones-Gebert Oil, Inc.

Lease Name Kiras Well No. 1

Office Address 1007 Central Bldg., Wichita, Kansas

Character of Well (completed as Oil, Gas or Dry Hole) Dry Hole

Date well completed July 20 19 62

Application for plugging filed July 20 19 62

Application for plugging approved July 20 19 62


Plugging commenced July 20 19 62

Plugging completed July 20 19 62

Reason for abandonment of well or producing formation Dry Hole

If a producing well is abandoned, date of last production 19

Was permission obtained from the Conservation Division or its agents before plugging was commenced? Yes

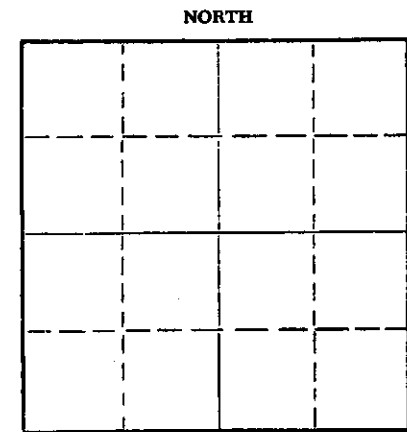

Locate well correctly on above Section Plat

Name of Conservation Agent who supervised plugging of this well Herman Justus

Producing formation _____ Depth to top _____ Bottom _____ Total Depth of Well 4617 Feet

Show depth and thickness of all water, oil and gas formations.

OIL, GAS OR WATER RECORDS

CASING RECORD

FORMATION	CONTENT	FROM	TO	SIZE	PUT IN	PULLED OUT
				8-5/8"	903'	

Describe in detail the manner in which the well was plugged, indicating where the mud fluid was placed and the method or methods used in introducing it into the hole. If cement or other plugs were used, state the character of same and depth placed, from _____ feet to _____ feet for each plug set.

Set bottom plug @400' with 1/2 sx. hulls, and 20 sx. cement, mud up to 40', set plug with 1/2 sx. hulls and 8 sx. cement, 2 sx. cement in rat hole.

RECEIVED
STATE CORPORATION COMMISSION
JUL 25 1962
7-25-62
CONSERVATION DIVISION
Wichita, Kansas

(If additional description is necessary, use BACK of this sheet)

Name of Plugging Contractor Jones-Gebert Oil, Inc.

Address 1007 Central Bldg., Wichita, Kansas

STATE OF Kansas COUNTY OF Sedgwick ss.

George R. Jones (owner or operator) of the above-described well, being first duly sworn on oath, says: That I have knowledge of the facts, statements, and matters herein contained and the log of the above-described well as filed and that the same are true and correct. So help me God.

(Signature) George R. Jones


1007 Central Bldg., Wichita, Kansas

(Address)

Subscribed and sworn to before me this 24th day of July, 19 62

My commission expires February 1, 1964

Barbara J. Layton
Barbara J. Layton Notary Public.

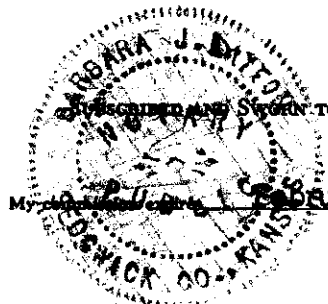

DRILLERS' LOG

Company:	Jones-Gebert Oil, Inc.
Contractor:	Jones-Gebert Oil, Inc.
Farm:	Kiras #1
Location:	NW NW SE, Sec. 2-30S-14W Barber County, Kansas
Commenced:	6-26-62
Completed:	7-20-62
Casing:	8-5/8" @903' w/300 sx.

0	-	254	Surface sand & red bed
254	-	645	Red bed and shale
645	-	892	Red bed and sand
892	-	904	Red bed and sand
904	-	1600	Red bed and shale
1600	-	1725	Shale and limestreaks
1725	-	1922	Shale and limestreaks
1922	-	2042	Lime and shale
2042	-	2161	Shale and lime streaks
2161	-	2276	Lime and shale
2276	-	2400	Lime
2400	-	2472	Lime
2472	-	2550	Lime
2550	-	2645	Lime
2645	-	2777	Lime and shale
2777	-	2915	Lime and shale
2915	-	3025	Shale and lime
3025	-	3182	Shale and lime
3182	-	3227	Lime and shale
3227	-	3340	Lime and shale
3340	-	3440	Lime and shale
3440	-	3550	Lime and shale
3550	-	3622	Lime
3622	-	3775	Lime
3775	-	3902	Lime
3902	-	3960	Lime and shale
3960	-	4016	Lime
4016	-	4068	Lime
4068	-	4073	K.C. Lime
4073	-	4107	K.C. lime
4107	-	4150	K.C. lime
4150	-	4170	K.C. lime
4170	-	4218	K.C. lime
4218	-	4265	K.C. lime
4265	-	4288	K.C. lime
4288	-	4315	Lime
4315	-	4333	Lime
4333	-	4373	Lime
4373	-	4416	Lime and shale streaks
4416	-	4445	Lime

RECEIVED
STATE CORPORATION COMMISSION

JUL 25 1962
7-25-62
CONSERVATION DIVISION
Wichita, Kansas

Drillers' Log

Page -2-

4445	-	4468	Core #1
4468	-	4485	Core #2
4485	-	4508	Lime and chert
4508	-	4545	Lime and chert
4545	-	4557	Chert and lime
4557	-	4559	Chert and lime
4559	-	4607	Chert and lime
4607	-	4617	Chert and sand
		4617	Rotary Total Depth

I, George R. Jones, do hereby certify that the above and foregoing is a true and correct copy of the log of the #1 Kras, NW NW SE, Sec. 2-30S-14W, Barber County, Kansas as reflected by the files of Jones-Gebert Oil, Inc.



 George R. Jones

State of Kansas)
) ss:
 County of Sedgwick)

State of Kansas, I, _____, do hereby certify that the above and foregoing is a true and correct copy of the log of the #1 Kras, NW NW SE, Sec. 2-30S-14W, Barber County, Kansas as reflected by the files of Jones-Gebert Oil, Inc. on this 25th day of July, 1962.

My commission expires:
 February 1964



 Barbara J. Layton, Notary Public

RECEIVED
 STATE CORPORATION COMMISSION
 JUL 25 1962
 7-25-62
 CONSERVATION DIVISION
 Wichita, Kansas