


STATE OF KANSAS  
STATE CORPORATION COMMISSION

## WELL PLUGGING RECORD

Give All Information Completely  
Make Required Affidavit  
Mail or Deliver Report to  
Conservation Division  
State Corporation Comm.  
245 North Water  
Wichita, KS 67202

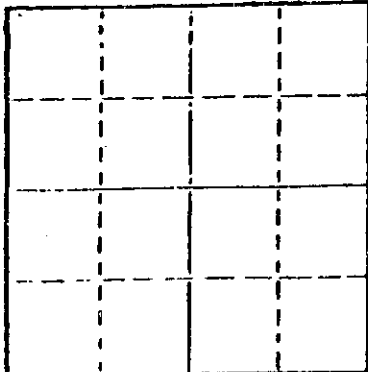

Locate well correctly on above  
Section Plat

Barber County. Sec. 2 Twp. 31S Rge. 11 E/W  
Location as "NE/CNW $\frac{1}{4}$ SW $\frac{1}{4}$ " or footage from lines  
C SW NW

Lease Owner Edwards Energy Corporation

Lease Name Rehme Well No. 1

Office Address 4925 Greenville, Dallas, Texas 75206

Character of Well (Completed as Oil, Gas or Dry Hole)

D&S

Date Well completed 6/27/79 19

Application for plugging filed 6/27/79 19

Application for plugging approved 6/27/79 19

Plugging commenced 6/27/79 19

Plugging completed 6/27/79 19

Reason for abandonment of well or producing formation

If a producing well is abandoned, date of last production 19

Was permission obtained from the Conservation Division or  
its agents before plugging was commenced? Yes

Name of Conservation Agent who supervised plugging of this well Wm. T. Owen

Producing formation Depth to top Bottom Total Depth of Well

Show depth and thickness of all water, oil and gas formations. RTD 4890'

## OIL, GAS OR WATER RECORDS

## CASING RECORD

FORMATION	CONTENT	FROM	TO	SIZE	PUT IN	PULLED OUT
	Surface	0	T.D.	8-5/8"	yes	no

Describe in detail the manner in which the well was plugged, indicating where the mud fluid was placed and the method or methods used in introducing it into the hold. If cement or other plugs were used, state the character of same and depth placed, from feet to feet for each plug set.

1st plug @ 240' with 40 sacks 50/50 Poz 6% gel

Bridge @ 40' with 12 sacks 50/50 Poz, 6% gel

3 sacks in rathole

Job complete @ 11:15 a.m. 6/27/79

RECEIVED  
STATE CORPORATION COMMISSION  
7-5-79  
JUL - 5 1979

(If additional description is necessary, use BACK of this sheet)

Name of Plugging Contractor Slawson Drilling Company, Inc.

STATE OF Kansas COUNTY OF Sedgwick, ss.

James C. Remsberg, Slawson Drilling Company, Inc. (employee of owner) or (owner or operator of the above-described well, being first duly sworn on oath, says: That I have knowledge of the facts, statements, and matters herein contained and the log of the above-described well as filed and that the same are true and correct. So help me God.


(Signature)

James C. Remsberg  
200 Douglas Building, Wichita 67202  
(Address)

SUBSCRIBED AND SWORN TO before me this 3 day of July, 1979

Mary Lou Taylor  
Mary Lou Taylor Notary Public.

My commission expires January 17, 1981

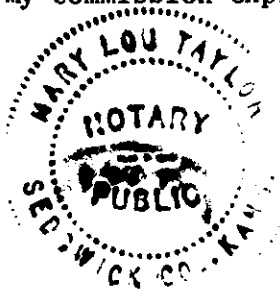

DRILLERS LOG

OPERATOR: Edwards Energy Corporation  
4925 Greenville, Suite 650  
Dallas, Texas 75206

LEASE: Rehme #1  
C SW NW Sec. 3-31S-11W  
Barber County, Kansas

CONTRACTOR: Slawson Drilling Company, Inc.  
200 Douglas Building  
Wichita, Kansas 67202

COMMENCED: 6/17/79

COMPLETED: 6/27/79

RTD: 4890'

SURF. CASING: 8-5/8" set at 249' with 225 sx cement

0' to 200' Surface Hole  
200' to 255' Shale & Sand (255' of 12 $\frac{1}{4}$ " Surface Hole)  
255' to 1916' Shale  
1916' to 3618' Shale & Lime  
3618' to 3880' Lime & Shale  
3880' to 4025' Shale & Lime  
4025' to 4295' Lime & Shale  
4295' to 4410' Shale & Lime  
4410' to 4750' Lime  
4750' to 4802' Lime (Viola)  
4802' to 4870' Lime  
4870' to 4890' Simpson  
4890' RTD

STATE OF KANSAS

COUNTY OF SEDGWICK

I, James C. Remsberg, of the Slawson Drilling Company, Inc.  
hereby state the above and foregoing is an accurate copy of the Rehme No.1  
log for Edwards Energy Corporation.

*James C. Remsberg*  
James C. Remsberg

Subscribed and sworn to me this  
3rd day of July, 1979

*Mary Lou Taylor*  
Mary Lou Taylor, Notary

My commission expires January 17, 1981

RECEIVED  
STATE CORPORATION COMMISSION  
JUL - 5 1979  
7-5-79  
CONSERVATION DIVISION  
Wichita, Kansas

