

STATE OF KANSAS  
STATE CORPORATION COMMISSION


WELL PLUGGING RECORD

RECEIVED  
STATE CORPORATION COMMISSION  
4-11-80  
APR 11 1980  
CONSERVATION DIVISION  
Wichita, Kansas

Give All Information Completely  
Make Required Affidavit  
Mail or Deliver Report to  
Conservation Division  
State Corporation Comm.  
245 North Water  
Wichita, KS 67202

County. Barber Sec. 2 Twp. 31S Rge. 11 NW  
Location as "NE/CNW 1/4 SW 1/4" or footage from lines C-NE-SE

Lease Owner Hawkins Oil and Gas  
Lease Name MEASE Well No. 1-2  
Office Address Box 1578, Liberal, KS 67901  
Character of Well (Completed as Oil, Gas or Dry Hole) DRY

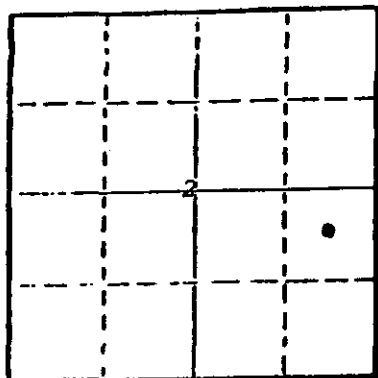

Locate well correctly on above Section Plot

Date Well completed April 5, 1980  
Application for plugging filed 19  
Application for plugging approved verbal 4/5/80 19  
Plugging commenced April 5, 1980  
Plugging completed April 5, 1980  
Reason for abandonment of well or producing formation DRY HOLE

If a producing well is abandoned, date of last production 19

Was permission obtained from the Conservation Division or its agents before plugging was commenced? YES

Name of Conservation Agent who supervised plugging of this well Wm. T. Owen, Pratt, KS  
Producing formation \_\_\_\_\_ Depth to top \_\_\_\_\_ Bottom \_\_\_\_\_ Total Depth of Well 4902  
Show depth and thickness of all water, oil and gas formations.

OIL, GAS OR WATER RECORDS

CASING RECORD

FORMATION	CONTENT	FROM	TO	SIZE	PUT IN	PULLED OUT
				8-5/8"	316'	None

Describe in detail the manner in which the well was plugged, indicating where the mud fluid was placed and the method or methods used in introducing it into the hold. If cement or other plugs were used, state the character of same and depth placed, from \_\_\_\_\_ feet to \_\_\_\_\_ feet for each plug set.

Plugged well as follows: 40 sacks at 300', 10 sacks at 40' to 0', 5 sacks rat-hole, 5 sacks mousehole. Job completed at 12:45 PM 4/5/80. Cut off pipe and welded on ID cap.


(If additional description is necessary, use BACK of this sheet)

Name of Plugging Contractor Allied Cementing Company, Kiowa, KS 67070

STATE OF Kansas COUNTY OF Seward, ss.  
Ned E. Lowry (employee of owner) or (owner or operator)  
of the above-described well, being first duly sworn on oath, says: That I have knowledge of the facts, statements, and matters herein contained and the log of the above-described well as filed and that the same are true and correct. So help me God.

(Signature) Ned E. Lowry  
P.O. Box 1578, Liberal, KS 67901  
(Address)

SUBSCRIBED AND SWORN TO before me this 9th day of April, 19 80

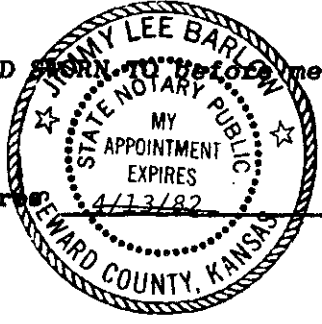

My commission expires \_\_\_\_\_

Jimmy Lee Barlow  
Notary Public.