


STATE OF KANSAS  
STATE CORPORATION COMMISSION

WELL PLUGGING RECORD

Give All Information Completely  
Make Required Affidavit  
Mail or Deliver Report to  
Conservation Division  
State Corporation Comm.  
245 North Water  
Wichita, KS 67202

Barber County, Sec. 20 Twp. 32S Rge. 11W ~~R2W~~  
Location as "NE/CNW $\frac{1}{4}$ /SW $\frac{1}{4}$ " or footage from lines 50' E of C NE SE  
Lease Owner Hummon Corporation  
Lease Name Lukens Well No. 1  
Office Address 400 One Main Place, Wichita, Ks. 67202  
Character of Well (Completed as Oil, Gas or Dry Hole) Dry Hole

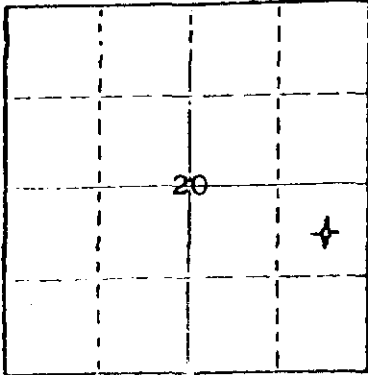

Date Well completed June 7, 1980  
Application for plugging filed June 7, 1980  
Application for plugging approved June 7, 1980  
Plugging commenced June 7, 1980  
Plugging completed June 7, 1980  
Reason for abandonment of well or producing formation Dry Hole

If a producing well is abandoned, date of last production 19

Was permission obtained from the Conservation Division or its agents before plugging was commenced? Yes

Name of Conservation Agent who supervised plugging of this well Wm. T. Owen  
Producing formation \_\_\_\_\_ Depth to top \_\_\_\_\_ Bottom \_\_\_\_\_ Total Depth of Well 4460  
Show depth and thickness of all water, oil and gas formations.

OIL, GAS OR WATER RECORDS

CASING RECORD

FORMATION	CONTENT	FROM	TO	SIZE	PUT IN	PULLED OUT
		0'	218'	8-5/8"	211.34'	None

Describe in detail the manner in which the well was plugged, indicating where the mud fluid was placed and the method or methods used in introducing it into the hold. If cement or other plugs were used, state the character of same and depth placed, from \_\_\_\_\_ feet to \_\_\_\_\_ feet for each plug set.

Plugged with 40 sacks cement at 210';  
plug and 1/2 sack hulls and 10 sacks  
cement at 40'; 5 sacks cement in rat hole.

(If additional description is necessary, use BACK of this sheet)

Name of Plugging Contractor Allied Cementing Co.

STATE OF KANSAS COUNTY OF SEDGWICK, ss.  
John D. Knightley Agent (employee of owner) or (owner or operator  
of the above-described well, being first duly sworn on oath, says: That I have knowledge of  
the facts, statements, and matters herein contained and the log of the above-described well  
as filed and that the same are true and correct. So help me God.

(Signature) [Signature]  
221 S. Broadway, Wichita, Kansas 67202  
(Address)

SUBSCRIBED AND SWORN TO before me this 18th day of June, 1980

[Signature] Notary Public.  
My commission expires March 12, 1983



Hummon Corporation  
 400 One Main Place  
 Wichita, Kansas 67202

-

Lukens #1  
 50' E of C NE SE  
 Sec. 20-32S-11W  
 Barber County, Kansas

Contractor: D. R. Lauck Oil Company, Inc.  
 221 S. Broadway, Suite 400  
 Wichita, Kansas 67202

Commenced: May 30, 1980  
 Completed: June 7, 1980

Drillers Log

Red Bed	350
Gyp	381
Shale	1007
Shale & Shells	1600
Shale	2676
Lime & Shale	2909
Shale & Lime	3615
Lime & Shale	3721
Shale & Lime	3867
Lime & Shale	4252
Lime	4460 RTD

6-20-80