


STATE OF KANSAS
STATE CORPORATION COMMISSION

WELL PLUGGING RECORD

Give All Information Completely
Make Required Affidavit
Mail or Deliver Report to
Conservation Division
State Corporation Comm.
245 North Water
Wichita, KS 67202

Barber County, Sec. 20 Twp. 32S Rge. 11W
Location as "NE/CNW/SW" or footage from lines
C SW SE

Lease Owner Hummon Corporation
Lease Name Sitler Well No. 1
Office Address Suite 400 One Main Place, Wichita, Kansas 67202
Character of Well (Completed as Oil, Gas or Dry Hole) Oil

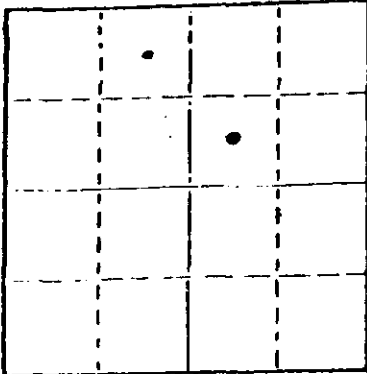

Locate well correctly on above
Section Plot

Date Well completed 10-16- 19 79
Application for plugging filed 10-30 1980
Application for plugging approved 10-30 1980
Plugging commenced 11-6 1980
Plugging completed 11-12 3:00 1980
Reason for abandonment of well or producing formation Not Productive

If a producing well is abandoned, date of last production 5-26 1980

Was permission obtained from the Conservation Division or its agents before plugging was commenced? Yes

Name of Conservation Agent who supervised plugging of this well Carl Barnett
Producing formation Mississippi Depth to top 4411 Bottom 4413 Total Depth of Well 4472
Show depth and thickness of all water, oil and gas formations.

OIL, GAS OR WATER RECORDS

CASING RECORD


FORMATION	CONTENT	FROM	TO	SIZE	PUT IN	PULLED OUT
				3 5/8	312	None
				4 1/2	4463	3727

Describe in detail the manner in which the well was plugged, indicating where the mud fluid was placed and the method or methods used in introducing it into the hold. If cement or other plugs were used, state the character of same and depth placed, from _____ feet to _____ feet for each plug set.

Dumped in sand - From 4425 to 4400
4 sacks cement to 4300

Ripped pipe at 3727

Bailed hole down. Built bridge at 323 wood and rock
5 yards ready mix to surface

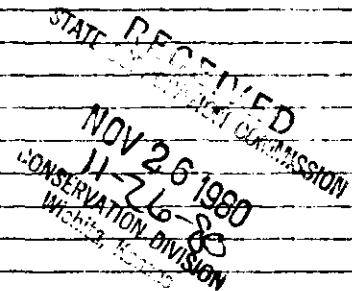

(If additional description is necessary, use BACK of this sheet)

Name of Plugging Contractor Clarke Corporation

STATE OF Kansas COUNTY OF Barber, ss.
Clmo R. Morgenstern (employee of ~~owner~~) or (~~owner or operator~~)
of the above-described well, being first duly sworn on oath, says: That I have knowledge of the facts, statements, and matters herein contained and the log of the above-described well as filed and that the same are true and correct. So help me God.

(Signature) Clmo R. Morgenstern
Medicine Lodge, Kansas
(Address)

SUBSCRIBED AND SWORN TO before me this 19th day of November, 1980

Jessie Hamilton
Notary Public.

My commission expires April 4, 1982.

Hummon Corporation
400 One Main Place
Wichita, Kansas 67202

Sitler #1
C SW SE Sec. 20-32S-11W
Barber County, Kansas

Contractor: D. R. Lauck Oil Company, Inc.
221 S. Broadway, Suite 400
Wichita, Kansas 67202

Commenced: October 16, 1979
Completed: October 25, 1979

Drillers Log

Shale	1873
Shale & Lime	2260
Shale	2555
Shale & Lime	3010
Shale & Shells	3260
Shale	3460
Shale & Lime	3650
Shells	3700
Lime & Shale	3840
Lime	4470 RTD

RECEIVED
STATE CORPORATION COMMISSION

OCT 31 1980
10-31-80
CONSERVATION DIVISION
Wichita, Kansas