


STATE OF KANSAS
STATE CORPORATION COMMISSION

WELL PLUGGING RECORD

Give All Information Completely
Make Required Affidavit
Mail or Deliver Report to
Conservation Division
State Corporation Comm.
245 North Water
Wichita, KS 67202

Barber County. Sec. 20 Twp. 32S Rge. 11W ~~R4E~~
Location as "NE/CNW $\frac{1}{4}$ SW $\frac{1}{4}$ " or footage from lines
C SE NW
Lease Owner Hummon Corporation
Lease Name Sitler Well No. 2
Office Address 400 One Main Place, Wichita, Ks. 67202
Character of Well (Completed as Oil, Gas or Dry Hole) _____

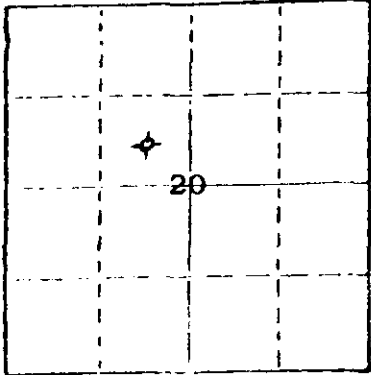

Dry Hole
Date Well completed November 3, 1979
Application for plugging filed November 3, 1979
Application for plugging approved November 3, 1979
Plugging commenced November 3, 1979
Plugging completed November 3, 1979
Reason for abandonment of well or producing formation _____

Dry Hole
If a producing well is abandoned, date of last production _____ 19____

Was permission obtained from the Conservation Division or its agents before plugging was commenced? Yes

Name of Conservation Agent who supervised plugging of this well Wm. T. Owen
Producing formation _____ Depth to top _____ Bottom _____ Total Depth of Well 4415
Show depth and thickness of all water, oil and gas formations.

OIL, GAS OR WATER RECORDS

CASING RECORD

FORMATION	CONTENT	FROM	TO	SIZE	PUT IN	PULLED OUT
		0'	309'	8-5/8"	302.15'	None

Describe in detail the manner in which the well was plugged, indicating where the mud fluid was placed and the method or methods used in introducing it into the hold. If cement or other plugs were used, state the character of same and depth placed, from _____ feet to _____ feet for each plug set.

Plugged with 40 sacks cement at 300',
10 sacks cement at 40', and 5 sacks
cement in rat hole.

(If additional description is necessary, use BACK of this sheet)

Name of Plugging Contractor Allied Cementing Co.

11-7-79

STATE OF KANSAS COUNTY OF SEDGWICK, ss.
John D. Knightley Agent (employee of owner) or (owner or operator
of the above-described well, being first duly sworn on oath, says: That I have knowledge of
the facts, statements, and matters herein contained and the log of the above-described well
as filed and that the same are true and correct. So help me God.

(Signature) [Signature]
221 S. Broadway, Wichita, Ks. 67202
(Address)

My commission expires March 12, 1983

Stella J. Lipp
Notary Public.



Hummon Corporation
400 One Main Place
Wichita, Kansas 67202

-

Sitler #2
C SE NW Sec. 20-32S-11W
Barber County, Kansas

Contractor: D.R. Lauck Oil Company, Inc.
221 S. Broadway, Suite 400
Wichita, Kansas 67202

Commenced: October 26, 1979
Completed: November 3, 1979

Drillers Log

Shale	556
Shale & Lime	1523
Shale & Shells	1860
Shale	2625
Shale & Lime	3595
Lime	4415 RTD

11-9-79