

STATE CORPORATION COMMISSION OF KANSAS
OIL & GAS CONSERVATION DIVISION

WELL COMPLETION OR RECOMPLETION FORM
ACO-1 WELL HISTORY

DESCRIPTION OF WELL AND LEASE

Operator: license # 5087
name Texas Energies, Inc.
address P.O. Box 947
City/State/Zip Pratt, KS 67124

Operator Contact Person Richard D. Harper
Phone 316-672-7581

Contractor: license # 5149
name Wheatstate Oilfield Services

Wellsite Geologist Greg Rinke
Phone 316-672-7581

PURCHASER N/A
Designate Type of Completion
 New Well Re-Entry Workover

Oil SWD Temp Abd
 Gas Inj Delayed Comp.
 Dry Other (Core, Water Supply etc.)

If OWWO: old well info as follows:
Operator
Well Name
Comp. Date Old Total Depth

WELL HISTORY

Drilling Method: Mud Rotary Air Rotary Cable
7-20-84 7-29-84 7-29-84
Spud Date Date Reached TD Completion Date
5025 N/A
Total Depth PBSD
Amount of Surface Pipe Set and Cemented at 950 feet
Multiple Stage Cementing Collar Used? Yes No
If Yes, Show Depth Set feet
If alternate 2 completion, cement circulated from feet depth to w/ SX cmt

API NO. 15-007-21,843-0000

County Barber

C S/2 NE SE Sec 4 Twp 33S Rge 14

1650 Ft North from Southeast Corner of Section
660 Ft West from Southeast Corner of Section
(Note: locate well in section plat below)


Lease Name Allen Well# 1-4

Field Name WC

Producing Formation N/A

Elevation: Ground 1876 KB 1889

Section Plat

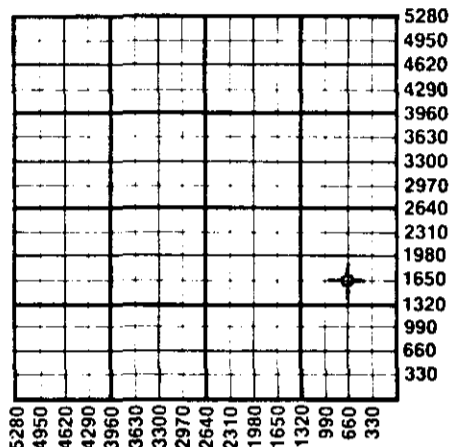

WATER SUPPLY INFORMATION

Source of Water:
Division of Water Resources Permit # N/A
 Groundwater Ft North From Southeast Corner and (Well) Ft West From Southeast Corner of Sec Twp Rge East West
 Surface Water Approx. 4620 Ft North From Southeast Corner and (Stream, Pond etc.) Approx. 660 Ft West From Southeast Corner Sec 9 Twp 33S Rge 14 East West
 Other (explain) (purchased from city, R.W.D.#)

Disposition of Produced Water: Disposal Repressuring
Docket #

INSTRUCTIONS: This form shall be completed in duplicate and filed with the Kansas Corporation Commission, 200 Colorado Building, Wichita, Kansas 67202, within 90 days after completion or recompletion of any well. Rules 82-3-130 and 82-3-107 apply.

Information on side two of this form will be held confidential for a period of 12 months if requested in writing and submitted with this form. See rule 82-3-107 for confidentiality in excess of 12 months.

One copy of all wireline logs and drillers time log shall be attached with this form. Submit CP-4 form with all plugged wells. Submit CP-111 form with all temporarily abandoned wells.

RECEIVED
STATE CORPORATION COMMISSION
SEP 07 1984
9-7-84
CONSERVATION DIVISION
Wichita, Kansas

All requirements of the statutes, rules, and regulations promulgated to regulate the oil and gas industry have been fully complied with and the statements herein are complete and correct to the best of my knowledge.

Signature Richard D. Harper
Title Production Geologist Date 9-5-84

Subscribed and sworn to before me this 5th day of September 19 84

Notary Public Sandy Patton
Date Commission Expires 8-27-85



K.C.C. OFFICE USE ONLY
F Letter of Confidentiality Attached
C Wireline Log Received
C Drillers Time Log Received
Distribution
 KCC SWD/Rep NGPA
 KGS Plug Other (Specify)

Form ACO-1
(This form supercedes previous forms ACO-1 & C-10)

Sec. 4 Twp. 33S Rge. 14W

Operator Name Texas Energies, Inc. Lease Name Allen Well# 1-4 SEC 4 TWP 33S RGE 14 East West

WELL LOG

INSTRUCTIONS: Show important tops and base of formations penetrated. Detail all cores. Report all drill stem tests giving interval tested, time tool open and closed, flowing and shut-in pressures, whether shut-in pressure reached static level, hydrostatic pressures, bottom hole temperature, fluid recovery, and flow rates if gas to surface during test. Attach extra sheet if more space is needed. Attach copy of log.

Drill Stem Tests Taken Yes No
 Samples Sent to Geological Survey Yes No
 Cores Taken Yes No

Formation Description
 Log Sample

DST #1 4744-4772 (Miss.) Time 30-45-45-60. IHP 2345; IFP 68-186; ISIP 1668; FFP 203-329; FSIP 1643; FHP 2276. Gas to surface on final shut in. Rec. 90' mud, 630' salt water.

Name	Top	Bottom
Onaga	3089	(-1205)
Wabaunsee	3136	(-1252)
Stotler	3286	(-1397)
Topeka	3544	(-1655)
Heebner	3994	(-2105)
Douglas	4050	(-2161)
Lansing	4622	(-2733)
Marmaton	4633	(-2744)
Miss.	4755	(-2866)
Kind.	4986	(-3097)
L.T.D.	5024	(-3135)

*3089
1205
1844*

CASING RECORD <input checked="" type="checkbox"/> new <input type="checkbox"/> used							
Report all strings set - conductor, surface, intermediate, production, etc.							
Purpose of string	size hole drilled	size casing set (in O.D.)	weight lbs/ft.	setting depth	type of cement	# sacks used	type and percent additives
Conductor		16		30	3 yards 6	sx grout	
Surface	12 1/4	8 5/8	23	950	Lite	150	3% CC
					Common	150	3% CC

PERFORATION RECORD		Acid, Fracture, Shot, Cement Squeeze Record	
shots per foot	specify footage of each interval perforated	(amount and kind of material used)	Depth

TUBING RECORD			Liner Run <input type="checkbox"/> Yes <input type="checkbox"/> No	
size	set at	packer at		

Date of First Production	Producing method <input type="checkbox"/> flowing <input type="checkbox"/> pumping <input type="checkbox"/> gas lift <input type="checkbox"/> Other (explain)			

Estimated Production Per 24 Hours	Oil	Gas	Water	Gas-Oil Ratio	Gravity
	Bbls	MCF	Bbls	CFPB	

METHOD OF COMPLETION open hole perforation other (specify) _____

Disposition of gas: vented sold used on lease

Dually Completed. Commingled

PRODUCTION INTERVAL _____