

STATE CORPORATION COMMISSION OF KANSAS  
OIL & GAS CONSERVATION DIVISION

WELL COMPLETION OR RECOMPLETION FORM  
ACO-1 WELL HISTORY

DESCRIPTION OF WELL AND LEASE

Operator: license # 9810  
name T. H. McElvain Oil & Gas Properties  
address P.O. Box 2148

City/State/Zip Santa Fe, NM 87504-2148

Operator Contact Person George B. Broone  
Phone 505-982-1935

Contractor: license # 5302  
name Red Tiger Drilling Company

Wellsite Geologist C. C. Van Buskirk  
Phone 316-262-5646

PURCHASER Kansas Power & Light

Designate Type of Completion  
 New Well  Re-Entry  Workover

Oil  SWD  Temp Abd  
 Gas  Inj  Delayed Comp.  
 Dry  Other (Core, Water Supply etc.)

OWWO: old well info as follows:  
Operator  
Well Name  
Comp. Date Old Total Depth

WELL HISTORY

Drilling Method:  Mud Rotary  Air Rotary  Cable  
1-21-86 2-1-86 3-11-86  
Spud Date Date Reached TD Completion Date

5065' 4605'  
Total Depth PBDT

Amount of Surface Pipe Set and Cemented at 343' feet

Multiple Stage Cementing Collar Used?  Yes  No

If Yes, Show Depth Set feet

Alternate 2 completion, cement circulated  
from feet depth to w/ SX cmt

API NO. 15-007-22,121-0000

County Barber

SE/4 SE/4 Sec 3 Twp 33S Rge 13W West

605 Ft North from Southeast Corner of Section  
605 Ft West from Southeast Corner of Section  
(Note: locate well in section plat below)


Lease Name Eva Weidner Well# 1

Field Name Wildeat Medicine Lodge-Boggs

Producing Formation Mississippian

Elevation: Ground 1681 KB 1686

Section Plat

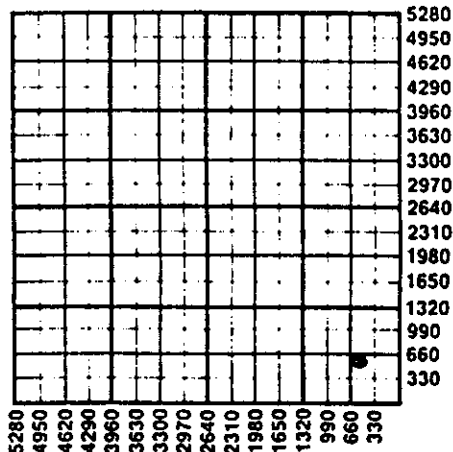

WATER SUPPLY INFORMATION

Source of Water:

Division of Water Resources Permit #

Groundwater Ft North From Southeast Corner of (Well) Ft. West From Southeast Corner of Sec Twp Rge  East  West

Surface Water 4800 Ft North From Southeast Corner of (Stream, Pond etc.) 4100 Ft West From Southeast Corner of Sec 2 Twp 33S Rge 13  East  West

Pete Magnison, RFD #1, Medicine Lodge, Ks. 67104

Other (explain) (purchased from city, R.W.D.#)

Disposition of Produced Water:  Disposal  Repressuring

Docket #

INSTRUCTIONS: This form shall be completed in duplicate and filed with the Kansas Corporation Commission, 200 Colorado Derby Building, Wichita, Kansas 67202, within 90 days after completion or recompletion of any well. Rules 82-3-130 and 82-3-107 apply.

Information on side two of this form will be held confidential for a period of 12 months if requested in writing and submitted with the form. See rule 82-3-107 for confidentiality in excess of 12 months.

One copy of all wireline logs and drillers time log shall be attached with this form. Submit CP-4 form with all plugged wells. Submit CP-111 form with all temporarily abandoned wells.

All requirements of the statutes, rules, and regulations promulgated to regulate the oil and gas industry have been fully complied with and the statements herein are complete and correct to the best of my knowledge.

Signature George B. Broone  
Title Geological Engineer Date 4-17-86

Subscribed and sworn to before me this 17th day of April 1986

Notary Public Barbara A. Lindsey  
State Commission Expires 6-29-1986

K.C.C. OFFICE USE ONLY  
 Letter of Confidentiality Attached  
 Wireline Log Received  
 Drillers Timelog Received  
Distribution  
 KCC  SWD/Rep  NGPA  
 KGS  Plug  Other (Specify)

FILED STATE CORPORATION COMMISSION

APR 28 1986  
4-28-86  
CONSERVATION DIVISION  
Wichita, Kansas

Form ACO-1 (7-84)

Sec. 33, Rge. 13W