

STATE OF KANSAS  
STATE CORPORATION COMMISSION


Give All Information Completely  
Make Required Affidavit  
Mail or Deliver Report to:  
Conservation Division  
State Corporation Commission  
211 No. Broadway  
Wichita, Kansas

*R*  
WELL PLUGGING RECORD

**BARBER** County, Sec. **19** Twp. **33S** Rge. **13** (~~E~~) (W)

Location as "NE/CNW/SW" or footage from lines **NW NW SW**  
Lease Owner **Mull Drilling Company, Inc.**  
Lease Name **Lenkner** Well No. **2**  
Office Address **Wichita, Kansas**  
Character of Well (completed as Oil, Gas or Dry Hole) \_\_\_\_\_  
Date well completed **February** 19 **56**  
Application for plugging filed \_\_\_\_\_ 19 \_\_\_\_\_  
Application for plugging approved \_\_\_\_\_ 19 \_\_\_\_\_  
Plugging commenced **January 4** 19 **60**  
Plugging completed **January 8** 19 **60**  
Reason for abandonment of well or producing formation \_\_\_\_\_

NORTH

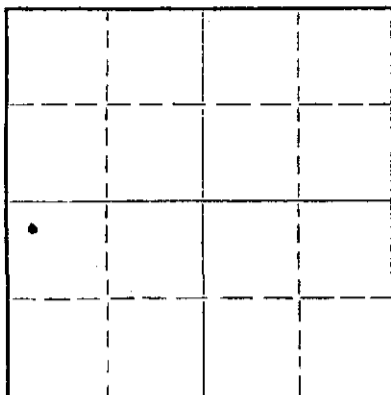

Locate well correctly on above  
Section Plat

If a producing well is abandoned, date of last production **November** 19 **58**  
Was permission obtained from the Conservation Division or its agents before plugging was commenced? **Yes**

Name of Conservation Agent who supervised plugging of this well **Fred Hampel**  
Producing formation \_\_\_\_\_ Depth to top \_\_\_\_\_ Bottom \_\_\_\_\_ Total Depth of Well \_\_\_\_\_ Feet  
Show depth and thickness of all water, oil and gas formations.

OIL, GAS OR WATER RECORDS

CASING RECORD

FORMATION	CONTENT	FROM	TO	SIZE	PUT IN	PULLED OUT
				8 5/8	200	
				5 1/2	4744	3765'

Describe in detail the manner in which the well was plugged, indicating where the mud fluid was placed and the method or methods used in introducing it into the hole. If cement or other plugs were used, state the character of same and depth placed, from \_\_\_\_\_ feet to \_\_\_\_\_ feet for each plug set.

**Sand to 4620** 5 sacks cement  
**Mud to 200'**  
**10' rock bridge** 20 sacks cement

**Mud to 35'**  
**10' rock bridge** 10 sacks cement

**RECEIVED**  
STATE CORPORATION COMMISSION

JAN 20 1960  
1-20-60  
CONSERVATION DIVISION  
Wichita, Kansas

(If additional description is necessary, use BACK of this sheet)

Name of Plugging Contractor \_\_\_\_\_  
Address \_\_\_\_\_

STATE OF **KANSAS**, COUNTY OF **SEDGWICK**, ss.  
**D. G. Comstock**

(employee of owner) or (owner or operator) of the above-described well, being first duly sworn on oath, says: That I have knowledge of the facts, statements, and matters herein contained and the log of the above-described well as filed and that the same are true and correct. So help me God.

(Signature) *D. G. Comstock*  
*Arthur Jones*  
(Address) \_\_\_\_\_

SUBSCRIBED AND SWORN TO before me this **18th** day of **January**, 19 **60**

My commission expires **February 24, 1960**  
*Madge N. Miller*  
**Madge N. Miller** Notary Public.



15-007-01411-0000

*Lenkner #2  
Producing well file*

ROTARY DRILLERS LOG

COMPANY : Mull Drilling Company, Inc. ROTARY DRILLING COMMENCED: 2-25-56  
 Wichita, Kansas

CONTRACTOR : Mull Drilling Company, Inc. ROTARY DRILLING COMPLETED: 3-9-56  
 Wichita, Kansas

CASING RECORD : Set 8 5/8" @ 200' cemented with 165 sacks cement.  
 Set 5 1/2" @ 1744' cemented with 150 sacks cement.

LOCATION: LENKNER #2  
 NW NW SW of Sec. 19-338-13W  
 Barber County, Kansas

(Figures indicate bottom of formation - measurements from top of Rotary Bushing)

Sand	40	Sandy Shale & Lime	3270
Red Rock	200	Shale & Lime	3798
Red Bed & Shells	820	Shale, Sand & Lime	3921
Shale & Shells	1450	Lime & Shale	4213
Shale & Lime	1950	Lime	4586
Lime	2180	Lime & Shale	4704
Lime & Shale	3050	Lime (Mississippi)	4744 R.T.D.

I hereby certify that this is a true and correct copy of the above log to the best of my knowledge.

MULL DRILLING COMPANY, INC.

BY *J. A. Mull, Jr.*, PRESIDENT  
 J. A. MULL, JR.

STATE OF KANSAS )  
 ) SS  
 COUNTY OF SEDGWICK )

Subscribed and sworn to before me this 14th day of March, 1956.

*Ethel Zimmerman*  
 NOTARY PUBLIC

MY COMMISSION EXPIRES: January 28, 1957

RECEIVED  
 STATE COMMISSIONER OF  
 OCT 11 1962  
 10-11-62  
 CONSERVATION DIVISION  
 Wichita, Kansas