


WELL PLUGGING RECORD

Give All Information Completely
Make Required Affidavit
Mail or Deliver Report to:
Conservation Division
State Corporation Commission
212 North Market, Insurance Bldg.
Wichita, Kansas

Barber County, Sec. 18 Twp. 33S Rge. 13 (E) (W)

NORTH

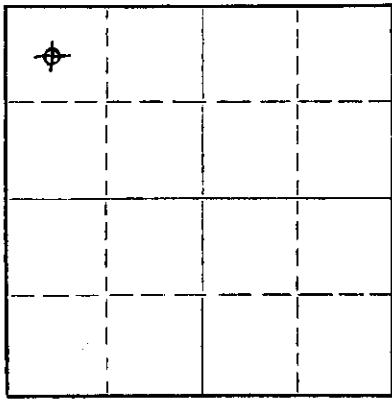

Locate well correctly on above
Section Plat

Location as "NE/CNW/SW" or footage from lines NW-NW
Lease Owner Barbara Oil Company
Lease Name Frank W. Storm Well No. 1
Office Address _____
Character of Well (completed as Oil, Gas or Dry Hole) Dry Hole
Date well completed September 10 19 67
Application for plugging filed September 10 19 67
Application for plugging approved September 10 19 67
Plugging commenced September 11 19 67
Plugging completed September 11 19 67
Reason for abandonment of well or producing formation D&A

If a producing well is abandoned, date of last production _____ 19 _____
Was permission obtained from the Conservation Division or its agents before plugging was commenced? Yes

Name of Conservation Agent who supervised plugging of this well A. Elving
Producing formation _____ Depth to top _____ Bottom _____ Total Depth of Well 5205 Feet
Show depth and thickness of all water, oil and gas formations.

OIL, GAS OR WATER RECORDS

CASING RECORD

FORMATION	CONTENT	FROM	TO	SIZE	PUT IN	PULLED OUT
				8 5/8"	223	None

Describe in detail the manner in which the well was plugged, indicating where the mud fluid was placed and the method or methods used in introducing it into the hole. If cement or other plugs were used, state the character of same and depth placed, from _____ feet to _____ feet for each plug set.

Plugged with mud from 5205' (Total depth) to 210'
Set bridge plug at 210'
Filled up with 30 sx cement to 120'
Filled up with mud to 40'
Set bridge plug @ 40'
Filled to surface with 15 sx cement
Put 2 sax of cement in rathole.

RECEIVED
STATE CORPORATION COMMISSION

SEP 20 1967
9-20-67

CONSERVATION DIVISION
Wichita, Kansas

(If additional description is necessary, use BACK of this sheet)

Name of Plugging Contractor Gabbert-Jones, Inc. (Rotary Contractor)
Address 830 Sutton Place, Wichita, Kansas

STATE OF Kansas, COUNTY OF Sedgwick, ss.
R. Douglas Myers (employee of owner) or (owner or operator) of the above-described well, being first duly sworn on oath, says: That I have knowledge of the facts, statements, and matters herein contained and the log of the above-described well as filed and that the same are true and correct. So help me God.

(Signature) R. Douglas Myers
509 Union Center, Wichita, Kansas
(Address)

SUBSCRIBED AND SWORN TO before me this 19th day of September, 19 67

My commission expires August 12, 1971

