


Give All Information Completely
Make Required Affidavit
Mail or Deliver Report to:
Conservation Division
State Corporation Commission
212 No. Market
Wichita, Kansas

WELL PLUGGING RECORD

NORTH

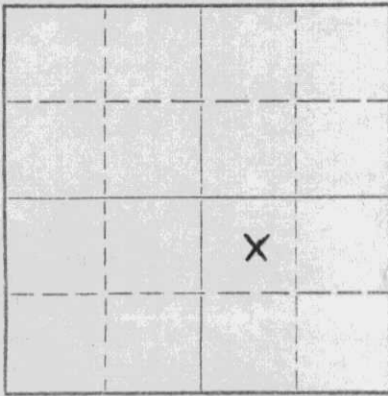

Locate well correctly on above
Section Plat

Barber County. Sec. 21 Twp. 31 Rge. 11 (E) W (W)
Location as "NE/CNWxSWx" or footage from lines. C NW SE
Lease Owner Bowers Drlg. Co., Inc.
Lease Name Chain Well No. #1
Office Address 1434 Wichita Plaza; Wichita, Kans. 67202
Character of Well (completed as Oil, Gas or Dry Hole) _____
Date well completed _____ 19____
Application for plugging filed May 19 70
Application for plugging approved May 19 70
Plugging commenced May 19 19 70
Plugging completed May 22 19 70
Reason for abandonment of well or producing formation _____
Produced out
If a producing well is abandoned, date of last production MApril 19 70
Was permission obtained from the Conservation Division or its agents before plugging was commenced? Yes

Name of Conservation Agent who supervised plugging of this well Russell Biberstein
Producing formation Douglas Depth to top _____ Bottom _____ Total Depth of Well 3802 Feet
Show depth and thickness of all water, oil and gas formations.

OIL, GAS OR WATER RECORDS

CASING RECORD

FORMATION	CONTENT	FROM	TO	SIZE	PUT IN	PULLED OUT
				8 5/8	245	None
				4 1/2	3798	3494

Describe in detail the manner in which the well was plugged, indicating where the mud fluid was placed and the method or methods used in introducing it into the hole. If cement or other plugs were used, state the character of same and depth placed, from _____ feet to _____ feet for each plug set.

May 19, 1970 Plugged off bottom. Dumped sand to 3750'. Mixed and dumped 4 sx of cement to 3700'.
May 22, 1970 Plugged off top. Set 10' rock bridge from 230' to 240', filled 8 5/8" casing full of ready mix concrete, from 230' to base of cellar.

RECEIVED
STATE CORPORATION COMMISSION
JUN 2 1970
CONSERVATION DIVISION
Wichita, Kansas

(If additional description is necessary, use BACK of this sheet)
Name of Plugging Contractor RUSS CASING PULLING, INC.
Address P. O. Box 1082 Great Bend, Kansas 67530


STATE OF KANSAS, COUNTY OF SEDGWICK, ss.
Emil E. Bowers (employee of owner) or (owner or operator) of the above-described well, being first duly sworn on oath, says: That I have knowledge of the facts, statements, and matters herein contained and the log of the above-described well as filed and that the same are true and correct. So help me God.

(Signature) Emil E. Bowers
125 No. Market, Suite 1434, Wichita, Kansas
(Address)

SUBSCRIBED AND SWORN TO before me this 1st day of June, 19 70

May 12, 1973

Carole A. Young
Carole A. Young Notary Public.

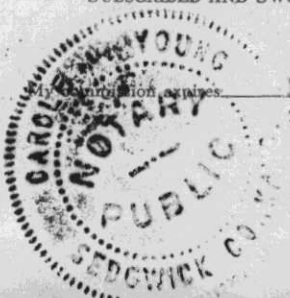

WELL LOG

COMPANY: Bowers Drilling Company, Inc. &
Western Oil Fields, Inc.
CONTRACTOR: Bowers Drilling Company, Inc.
FARM: Chain Unit #1
LOCATION: C NW SE Section 21-31S-11W
Barber County, Kansas
COMMENCED: March 30, 1966
COMPLETED: April 5, 1966
ELEVATION: 1768 Kelly Bushing

0 - 254	Sand	Set 5 5/8" surface casing at 254' with
254 - 1250	Redbed	200 sacks.
1250 - 1770	Shells and Lime	
1770 - 2385	Lime	
2385 - 3370	Shale and Lime	
3370 - 3570	Lime	
3570 - 3802	Shale and Sand	4 1/2" casing set at 3798' with 50 sacks.
3802	T. D.	

SAMPLE TOPS:

Elgin Zone	3554 (-1786)
Elgin Sand	3597 (-1829)
Heebner	3718 (-1950)
Douglas Shale	3725 (-1957)
Douglas Sand	3799 (-2031)
Rotary Total Depth	3802 (-2034)

RECEIVED
STATE CORPORATION COMMISSION
5-15-70
MAY 15 1970
CONSERVATION DIVISION
Wichita, Kansas

STATE OF KANSAS)
) SS
COUNTY OF SEDGWICK)

I, Emil E. Bowers, do hereby certify that the above and foregoing is a true and correct copy of the copy of the log of the Chain Unit #1 located C NW SE Section 21-31S-11W, Barber County, Kansas, as reflected by the files of Bowers Drilling Company, Inc.

Emil E. Bowers

Subscribed and sworn to before me, a Notary Public, in and for Sedgwick County, Kansas, this 20th day of April, 1966.

Donna F. Miller
Donna F. Miller, Notary Public

My commission expires May 1, 1966.