


WELL PLUGGING RECORD

Give All Information Completely
Make Required Affidavit
Mail or Deliver Report to:
Conservation Division
State Corporation Commission
211 No. Broadway
Wichita, Kansas

Harper County, Sec. 3 Twp. 33S Rge. 7W (E) (W)

Location as "NE/CNW&SWK" or footage from lines C SE SE NW
Lease Owner Sinclair Oil & Gas Company
Lease Name Lewis Sechler Well No. 1
Office Address P. O. Box 521, Tulsa, Oklahoma
Character of Well (completed as Oil, Gas or Dry Hole) Dry Hole
Date well completed 5-29 19 56
Application for plugging filed 5-31 19 56
Application for plugging approved 6-1 19 56
Plugging commenced 5-30 19 56
Plugging completed 5-30 19 56
Reason for abandonment of well or producing formation Dry Hole - No producing formation encountered.
If a producing well is abandoned, date of last production Dry Hole. 19
Was permission obtained from the Conservation Division or its agents before plugging was commenced? Yes - verbal approval granted 5-29-56.

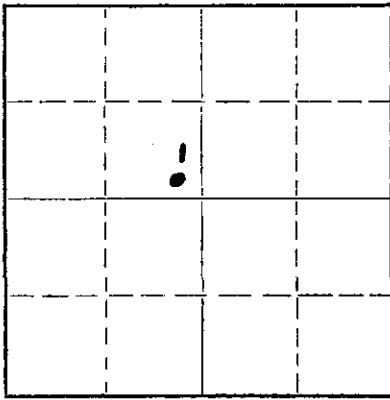

Locate well correctly on above Section Plat

Name of Conservation Agent who supervised plugging of this well Mr. R. M. Brundage, Box 283, Hoisington, Kansas
Producing formation None Depth to top Bottom Total Depth of Well 5098 Feet
Show depth and thickness of all water, oil and gas formations.

OIL, GAS OR WATER RECORDS

CASING RECORD

FORMATION	CONTENT	FROM	TO	SIZE	PUT IN	PULLED OUT
NONE - DRY HOLE				10-3/4"	271	None

Describe in detail the manner in which the well was plugged, indicating where the mud fluid was placed and the method or methods used in introducing it into the hole. If cement or other plugs were used, state the character of same and depth placed, from feet to feet for each plug set.

Filled hole with mud to 270'.
Dumped 1/3 sack hulls.
Set wooden plug at 270'.
Dumped cement from 270' to 195'.
Filled hole with mud from 195 to 35'.
Dumped 1/3 sack hulls.
Set wooden plug at 35'.
Dumped cement from 35' to 0'.
Welded steel plate over surface casing.

(If additional description is necessary, use BACK of this sheet)

Name of Plugging Contractor Barbour Drilling Company
Address 1612 First National Bldg., Tulsa, Oklahoma

STATE OF Kansas COUNTY OF Rice, ss.
W. B. Rhees (employee of owner) or (conservation agent) of the above-described well, being first duly sworn on oath, says: That I have knowledge of the facts, statements, and matters herein contained and the log of the above-described well as filed and that the same are true and correct. So help me God.

(Signature) W. B. Rhees
P. O. Box 551, Chase, Kansas
(Address)

SUBSCRIBED AND SWORN TO before me this 20th day of June, 19 56

My commission expires 19 June 1959 John Daniel Notary Public.

PLUGGING
FILE SEC 3 T33 R7W
BOOK PAGE 66 LINE 41

6-23-56

LEWIS SECHLER NO. 1

NW/4 of Section 3-33S-7W
 Harper County, Kansas
 Sinclair Oil and Gas Company

10-3/4" O. D. casing cemented at 271'

Drilling commenced May 8, 1956
 Drilling completed May 30, 1956

FROM	TO	FORMATION	REMARKS
0'	271'	Red bed, shale & shells	10-3/4" O. D. casing cemented with 200 sacks cement at 271'
271	510	Red bed & shale	
510	1187	Shale & shells	
1187	1230	Anhydrite & shale	
1230	1595	Shale & lime	
1595	1695	Shale	
1695	1835	Shale & lime	
1835	2015	Shale & lime streaks	
2015	2520	Shale	
2520	2894	Shale & lime	
2894	3035	Lime & shale	
3035	3395	Lime	
3395	3608	Lime & shale	
3608	3695	Stallnecker sand	
3695	3796	Sandy shale	
3796	3880	Sand, shale & lime	
3880	3965	Lime	
3965	4001	Lime - hard	
4001	4027	Limestone	
4027	4106	Lime	
4106	4170	Lime & shale	
4170	4390	Lime	
4390	4440	Lime & shale	
4440	4548	Lime	
4548	4620	Mississippi lime	
4620	4700	Lime	
4700	4734	Mississippi lime	
4734	4777	Lime	
4777	4790	Shale	
4790	4822	Lime	
4822	4862	Shale	
4862	4915	Shale & lime	Coring 4878' - 4915'
4915	4928	Sand	

PLUGGING
 FILE SEC. 3 T33 R 7W
 BOOK PAGE 66 LINE 41

JUN 1956
 CONSERVATION DIVISION
 Wichita, Kansas

FROM	TO	FORMATION	REMARKS
4928	4955	Lime & sand	
4955	4984	Sand	
4984	5004	Sand & shale	
5004	5032	Simpson sand	
5032	5078	Shale, sand & lime	
5078	5098	Lime	Well plugged
T.D. 5098*			

This is a true copy of the driller's log as shown on the drilling tickets.

BARBOUR DRILLING COMPANY

By *M. A. Burt*

Subscribed and sworn to before me on this 7th day of June, 1956.

Merry Jane Burt
Notary Public

My commission expires: July 27, 1957

