

15-077-20462-00-00

STATE OF KANSAS
STATE CORPORATION COMMISSION

WELL PLUGGING RECORD

Give All Information Completely
Make Required Affidavit
Mail or Deliver Report to
Conservation Division
State Corporation Comm.
245 North Water
Wichita, KS 67202

Harper County, Sec. 33 Twp. 32S Rge. 8W 1/2/W
Location as "NE/CNW 1/4 SW 1/4" or footage from lines
C NW/4 NE/4

Lease Owner National Cooperative Refinery Association
Lease Name Catlin Well No. 1
Office Address 404 Lincoln Tower Bldg., Denver, Colorado
Character of Well (Completed as Oil, Gas or Dry Hole)
D & A


Date Well completed February 12, 1978
Application for plugging filed February 12, 1978
Application for plugging approved February 12, 1978
Plugging commenced February 12, 1978
Plugging completed February 12, 1978

Reason for abandonment of well or producing formation
D & A

If a producing well is abandoned, date of last production
19

Was permission obtained from the Conservation Division or
its agents before plugging was commenced? Yes

Name of Conservation Agent who supervised plugging of this well Jasper H. Metz
Producing formation _____ Depth to top _____ Bottom _____ Total Depth of Well 4,900
Show depth and thickness of all water, oil and gas formations.

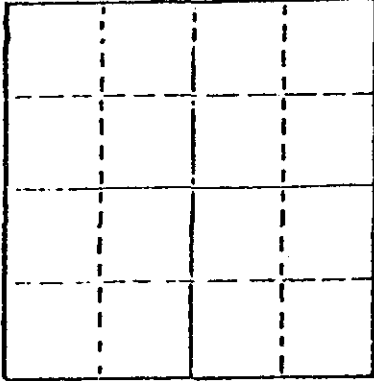

Locate well correctly on above
Section Plat

OIL, GAS OR WATER RECORDS

CASING RECORD

FORMATION	CONTENT	FROM	TO	SIZE	PUT IN	PULLED OUT
				8 5/8"	276.56	-0-

Describe in detail the manner in which the well was plugged, indicating where the mud fluid
was placed and the method or methods used in introducing it into the hold. If cement or other
plugs were used, state the character of same and depth placed, from _____ feet to
_____ feet for each plug set.

Plugged hole w/35 sx cement @ 280'
12 sx cement @ 40'
3 sx cement in rathole

RECEIVED
STATE CORPORATION COMMISSION

FEB 21 1978

(If additional description is necessary, use SEPARATE DIVISION SHEET)
Name of Plugging Contractor Red Tiger Drilling Company
1720 KSB&T Building, Wichita, Kansas 67202


STATE OF Kansas COUNTY OF Sedgwick, ss. contractor
Gloria Fawcett (employee of ~~XXXXXXXXXXXXXXXXXXXXXXXXXXXXXXXXXXXX~~)
of the above-described well, being first duly sworn on oath, says: That I have knowledge of
the facts, statements, and matters herein contained and the log of the above-described well
as filed and that the same are true and correct. So help me God.

(Signature) Gloria Fawcett
1720 KSB&T Building, Wichita, Kansas 67202
(Address)

SUBSCRIBED AND SWORN TO before me this 15th day of February, 1978.

Joyce A. Hagermann
Notary Public.

My commission expires _____

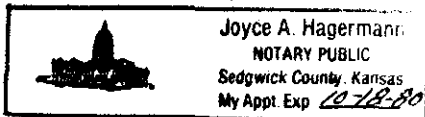

DRILLERS LOG

No. 1 Catlin

CASING RECORD:	COMPANY:	National Cooperative Refinery Asso.	DESCRIPTION:
8 5/8" @ 281' w/250 sx cement	CONTRACTOR:	Red Tiger Drilling Company	C NW/4 NE/4 Sec. 33-T32S-R8W Harper County, Kansas
	COMMENCED:	January 30, 1978	
	COMPLETED:	February 12, 1978	
TOTAL DEPTH: 4,900'			ELEVATION: 1,406' GR

<u>FORMATION</u>	<u>FROM</u>	<u>TO</u>	<u>REMARKS</u>
Rock	0	55	
Red Shale	55	286	
Red Bed	286	320	
Sand & Shale	320	1058	
Shale	1058	2120	
Lime & Shale	2120	2429	
Shale & Lime	2429	2670	
Lime & Shale	2670	3270	
Lime	3270	3430	
Lime & Shale	3430	3536	
Lime	3536	3930	
Lime & Shale	3930	4034	
Lime	4034	4525	
Lime & Shale	4525	4593	
Lime	4593	4900	
RTD		4900	

RECEIVED
STATE CORPORATION COMMISSION
FEB 21 1978
CONSERVATION DIVISION
Wichita, Kansas

I certify that this is a true and correct copy of the above log to the best of my knowledge.

RED TIGER DRILLING COMPANY

Gloria Fawcett
Gloria Fawcett

Subscribed and sworn to before me this 15th day of February, 1978.

Joyce A. Hagermann
Notary Public

