


STATE OF KANSAS
STATE CORPORATION COMMISSION

WELL PLUGGING RECORD

Give All Information Completely
Make Required Affidavit
Mail or Deliver Report to
Conservation Division
State Corporation Comm.
245 North Water
Wichita, KS 67202

Harper County, Sec. 23 Twp. 32S Rge. 8W 3/4
Location as "NE/CNW 1/4 SW 1/4" or footage from lines _____

C SW SW SW
Lease Owner McCoy Petroleum Corp.
Lease Name Wilson -Gill Well No. 2
Office Address 500 Heritage Park Place - Wichita Ks. 67202
Character of Well (Completed as Oil, Gas or Dry Hole) _____

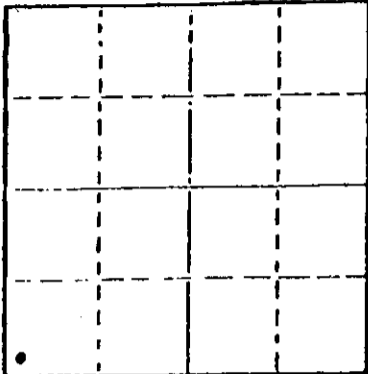

Locate well correctly on above
Section Plat

Dry Hole
Date Well completed 9-18 19 83
Application for plugging filed 9-18 19 83
Application for plugging approved 9-18 19 83
Plugging commenced 9-18 19 83
Plugging completed 9-18 19 83
Reason for abandonment of well or producing formation _____

Dry Hole
If a producing well is abandoned, date of last production 19 _____

Was permission obtained from the Conservation Division or its agents before plugging was commenced? Yes

Name of Conservation Agent who supervised plugging of this well Wayne Kirkpatrick
Producing formation _____ Depth to top _____ Bottom _____ Total Depth of Well _____
Show depth and thickness of all water, oil and gas formations.

OIL, GAS OR WATER RECORDS

CASING RECORD

FORMATION	CONTENT	FROM	TO	SIZE	PUT IN	PULLED OUT
Surface Pipe		0	254'	8 5/8"	254	None

Describe in detail the manner in which the well was plugged, indicating where the mud fluid was placed and the method or methods used in introducing it into the hold. If cement or other plugs were used, state the character of same and depth placed, from _____ feet to _____ feet for each plug set.

Filled hole with heavy mud

#1 Plug set @ 800' with 35 sacks cement

#2 Plug set @ 300' with 35 sacks cement

#3 Plug set @ 60' with 25 sacks cement

#4 Plug set in rat hole with 10 sacks cement

(If additional description is necessary, use BACK of this sheet)

Name of Plugging Contractor Sweetman Drilling Inc.

STATE OF Kansas COUNTY OF Sedgwick, ss.
John Roger McCoy (employee of owner) or (owner or operator)
of the above-described well, being first duly sworn on oath, says: That I have knowledge of the facts, statements, and matters herein contained and the log of the above-described well as filed and that the same are true and correct. So help me God.


(Signature) _____

(Address) _____

SUBSCRIBED AND SWORN TO before me this 20 day of July, 1984

Deborah Ann Paulus
Notary Public.

My commission expires January 8, 1988

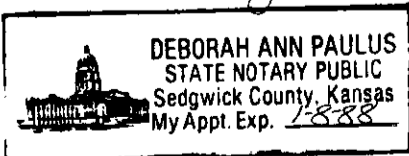

RECEIVED
STATE CORPORATION COMMISSION

JUL 23 1984

CONSERVATION DIVISION
Wichita, Kansas