


STATE OF KANSAS
STATE CORPORATION COMMISSION
CONSERVATION DIVISION
WICHITA, KANSAS

FORM CP-4

WELL PLUGGING RECORD

New Address
245 North Water
Wichita, Kansas 67202

Harper County, Sec. 25 Twp. 33 Rge. 8W (E) (W)

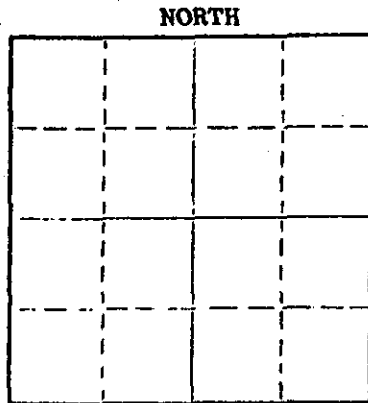

Locate well correctly on above Section Plat

Location as "NE/CNW&SW" or footage from lines NE SW
Lease Owner PICKRELL DRILLING COMPANY
Lease Name NORMAN-DALRYMPLE "B" UNIT Well No. I
Office Address 205 LITWIN BLDG., WICHITA, KS. 67202
Character of Well (completed as Oil, Gas or Dry Hole) Dry Hole
Date well completed 10-22-76 19
Application for plugging filed 10-22-76 19
Application for plugging approved 10-22-76 19
Plugging commenced 10-22-76 19
Plugging completed 10-22-76 19
Reason for abandonment of well or producing formation Dry Hole

If a producing well is abandoned, date of last production _____ 19
Was permission obtained from the Conservation Division or its agents before plugging was commenced? Yes

Name of Conservation Agent who supervised plugging of this well G. R. Boberstein
Producing formation _____ Depth to top _____ Bottom _____ Total Depth of Well 4710 Feet
Show depth and thickness of all water, oil and gas formations.

OIL, GAS OR WATER RECORDS

CASING RECORD

FORMATION	CONTENT	FROM	TO	SIZE	PUT IN	PULLED OUT
				8 5/8	210	None

Describe in detail the manner in which the well was plugged, indicating where the mud fluid was placed and the method or methods used in introducing it into the hole. If cement or other plugs were used, state the character of same and depth placed, from _____ feet to _____ feet for each plug set.

35 sacks - 200'
15 sacks - 40'
5 sacks - Rat Hole Comp. 11AM 10-22-76

11-18-76

Name of Plugging Contractor PICKRELL DRILLING COMPANY (If additional description is necessary, use BACK of this sheet)
Address 205 LITWIN BLDG., WICHITA, KS. 67202

STATE OF Kansas COUNTY OF Sedgwick ss.
C. W. Sebitts (employee of owner) or (owner or operator) of the above-described

well, being first duly sworn on oath, says: That I have knowledge of the facts, statements, and matters herein contained and the log of the above-described well as filed and that the same are true and correct. So help me God.

(Signature) C. W. Sebitts 205 Litwin Bldg., Wichita, Ks. 02

Subscribed and Sworn to before me this 27 day of October, 19 76

My commission expires _____
Jo Ann Sarver Notary Public.



ROTARY DRILLING LOG

COMPANY: PICKRELL DRILLING COMPANY
 205 Litwin Bldg.,
 Wichita, Ks. 67202
 LOCATION: Norman-Dalrymple "B" Unit #1
 NE SW Sec. 25-33S-8W
 Harper Co., Ks.
 CONTRACTOR: **PICKRELL DRILLING COMPANY**
Wichita, Kansas

Rotary Drilling Commenced 10-11-76
 Rotary Drilling Completed 10-22-76

CASING RECORD: Set 8 5/8" casing at 210' with 165 sacks common cement.

LOG

(Figures indicate bottom of formation — measurements from top of rotary bushing.)

Top Soil	15
Red Rock	210
Shale	885
Shale & Lime	1470
Shale & Lime	1720
Shale & Lime	1955
Lime & Shale	2145
Shale & Lime	2405
Shale	2680
Lime	2840
Shale & Lime	3075
Shale & Lime	3210
Shale & Lime	3360
Lime	3510
Shale	3615
Shale	3700
Lime	3810
Shale & Lime	3930
Lime	4020
Lime	4145
Lime & Shale	4220
Lime	4282
Shale & Lime	4300
Lime	4380
Shale & Lime	4435
Lime	4495
Lime	4566
Lime	4630
Lime	4689
Lime	4710

The undersigned, C. W. Sebitts, Attorney-in-Fact for PICKRELL DRILLING COMPANY, hereby certifies in behalf of said Company, that the above is a true and correct log of the formation encountered in drilling the above well as reflected by the Daily Drilling Reports.

PICKRELL DRILLING COMPANY
 By *[Signature]*
 Attorney-in-Fact

STATE OF KANSAS }
 COUNTY OF SEDGWICK } ss.:

C. W. Sebitts

On this 27 day of October, 1976, before me the undersigned, a Notary Public, in and for the County and State aforesaid, personally appeared C. W. Sebitts, to me known to be the identical person who subscribed the name of PICKRELL DRILLING COMPANY to the foregoing instrument as its Attorney-in-Fact and acknowledged to me that he executed the same as his free and voluntary act and deed, and as the free and voluntary act and deed of such company, for the uses and purposes therein set forth.

Given under my hand and seal of office the day and year last above written.

My commission expires: _____

[Signature]
 Notary Public
 JO ANN SARVER

