


15-077-20489-00-00

STATE OF KANSAS
STATE CORPORATION COMMISSION

WELL PLUGGING RECORD

Give All Information Completely
Make Required Affidavit
Mail or Deliver Report to
Conservation Division
State Corporation Comm.
245 North Water
Wichita, KS 67202

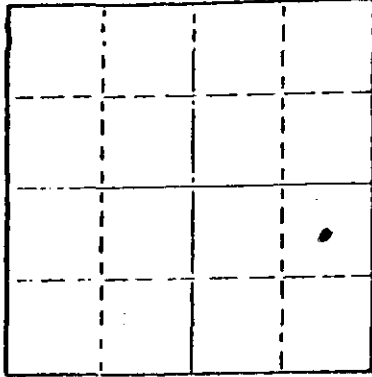

Locate well correctly on above
Section Plot

Harper County. Sec. 24 Twp. 33S Rge. 8W E/W
Location as "NE/CNW $\frac{1}{4}$ /SW $\frac{1}{4}$ " or footage from lines _____
C NE SW

Lease Owner McCoy Petroleum Co.
Lease Name Dalrymple C Well No. 1
Office Address 816 Vickers KSB & T Bldg. Wichita, Ks 67202
Character of Well (Completed as Oil, Gas or Dry Hole) _____

Dry Hole
Date Well completed 9-20 1978
Application for plugging filed 9-20 1978
Application for plugging approved 9-20 1978
Plugging commenced 9-20 1978
Plugging completed 9-20 1978
Reason for abandonment of well or producing formation _____

D & A
If a producing well is abandoned, date of last production _____
19 _____

Was permission obtained from the Conservation Division or
its agents before plugging was commenced? Yes

Name of Conservation Agent who supervised plugging of this well Bill Owens
Producing formation _____ Depth to top _____ Bottom _____ Total Depth of Well _____
Show depth and thickness of all water, oil and gas formations.

OIL, GAS OR WATER RECORDS

CASING RECORD

FORMATION	CONTENT	FROM	TO	SIZE	PUT IN	PULLED OUT
Surface pipe		-0-	242	8 5/8"	242	None

Describe in detail the manner in which the well was plugged, indicating where the mud fluid
was placed and the method or methods used in introducing it into the hold. If cement or other
plugs were used, state the character of same and depth placed, from _____ feet to
_____ feet for each plug set.

Filled hole with heavy mud.

#1 plug set @ 260' with 40 sacks cement

#2 plug set @ 40' with 12 sacks cement

#3 plug set in rat hole with 3 sacks cement

(If additional description is necessary, use BACK of this sheet)

Name of Plugging Contractor Sweetman Drilling, Inc.

STATE OF Kansas COUNTY OF Barton ss.

Gary L. Hawk

(employee of owner) or ~~(Conservation Agent)~~ of the above-described

well, being first duly sworn on oath, says: That I have knowledge of the facts, statements, and matters herein contained and the log of the
above-described well as filed and that the same are true and correct. So help me God.

(Signature)

Gary L. Hawk
Box 645 Great Bend, Kansas 67530

(Address)

Subscribed and Sworn to before me this 27th day of September, 19 78

My commission expires 8-1-81

Mary Ann Schwaborn
Notary Public.

STATE OF KANSAS
RECEIVED
9-28-78
COMMISSIONER OF CORP. AFFS.
WICHITA, KANSAS

WELL LOG -
Dalrymple- C-1
C NE SW 24-33S-8W
Harper County, Kansas

Name of Operator: McCoy Petroleum, Inc.
816 Vickers KSB & T Bldg.
Wichita, Kansas 67202


Date Completed: September 20, 1978

<u>FROM</u>	<u>TO</u>	
0	254	Sand and red bed
254	1075	Red bed and shale
1075	1805	Shale
1805	4135	Lime and shale
4135	4288	Lime
4288	4508	Lime and shale
4508	4845	Lime
4845	4995	Lime and shale
4995	5136	Lime
5136		Total Depth

STATE OF KANSAS

COUNTY OF BARTON ss

Gary L. Hawk, Secretary of Sweetman Drilling, Inc., being first duly sworn on oath says: That I have knowledge of the facts, statements and matters herein contained and the log of the above described well as filed and that the same are true and correct.


Gary L. Hawk

Subscribed and sworn before me this 26th day of September, 1978.


Notary Public Barton County

My Commission Expires 8-1--81.