

STATE OF KANSAS
STATE CORPORATION COMMISSION


WELL PLUGGING RECORD

Give All Information Completely
Make Required Affidavit
Mail or Deliver Report to:
Conservation Division
State Corporation Commission
211 No. Broadway
Wichita, Kansas

Barber County, Sec. 24 Twp. 32S Rge. 13 (W)

Location as "NE/CNW/SW" or footage from lines SE SE SW
Lease Owner Pickrell Drilling Company
Lease Name Lonker Well No. 1
Office Address 705 Fourth Nat'l. Bank Bldg, Wichita, Kansas
Character of Well (completed as Oil, Gas or Dry Hole) Dry Hole
Date well completed 11-30 19 58
Application for plugging filed 11-30 19 58
Application for plugging approved 11-30 19 58
Plugging commenced 11-30 19 58
Plugging completed 11-30 19 58
Reason for abandonment of well or producing formation D & A

NORTH

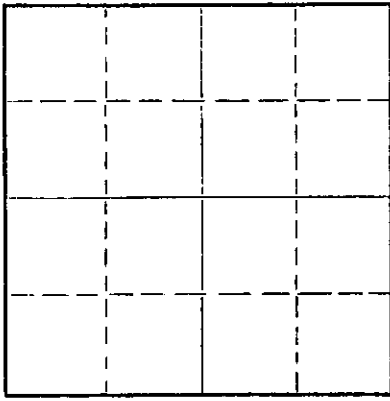

Locate well correctly on above
Section Plat

If a producing well is abandoned, date of last production 19
Was permission obtained from the Conservation Division or its agents before plugging was commenced? Yes

Name of Conservation Agent who supervised plugging of this well W. L. Lackamp
Producing formation _____ Depth to top _____ Bottom _____ Total Depth of Well 4455 Feet
Show depth and thickness of all water, oil and gas formations.

OIL, GAS OR WATER RECORDS

CASING RECORD

FORMATION	CONTENT	FROM	TO	SIZE	PUT IN	PULLED OUT
				8-5/8"	200'	None

Describe in detail the manner in which the well was plugged, indicating where the mud fluid was placed and the method or methods used in introducing it into the hole. If cement or other plugs were used, state the character of same and depth placed, from _____ feet to _____ feet for each plug set.

Filled with heavy mud to 180', bridge hole and cement with 20 sacks cement.

Then heavy mud to 39' below ground level, bridge hole and cement with 9 sacks cement to bottom of cellar.

RECEIVED
DEC 11 1958
CONSERVATION DIVISION
Wichita, Kansas

(If additional description is necessary, use BACK of this sheet)

Name of Plugging Contractor Pickrell Drilling Company
Address 705 Fourth National Bank Building, Wichita 2, Kansas

STATE OF KANSAS, COUNTY OF SEDGWICK, ss.

C. W. SEBITS (owner or operator) of the above-described well, being first duly sworn on oath, says: That I have knowledge of the facts, statements and matters herein contained and the log of the above-described well as filed and that the same are true and correct. So help me God.

(Signature)

705 Fourth Nat'l. Bank Bldg, Wichita, Kansas
(Address)

SUBSCRIBED AND SWORN TO before me this 10 th day of December, 19 58

My commission expires May 13, 1962

Mary Ellen Sampson
(Mary Ellen Sampson) Notary Public.

PLUGGING
FILE SEC 24 T 32 R 13W
BOOK PAGE 1 LINE 45

ROTARY DRILLING LOG

COMPANY: Pickrell Drilling Company

Rotary Drilling Commenced 11-16-58

LOCATION: SE SE SW Sec. 24-32S-13W
Barber County, Kansas

Rotary Drilling Completed 12-1-58

#1 Lonker

CONTRACTOR: PICKRELL DRILLING COMPANY
Wichita, Kansas

CASING RECORD: 200' of 8-5/8" surface casing, cemented with 125 sacks cement.
Cement Circulated.

No oil string run. D & A

LOG

(Figures indicate bottom of formation — measurements from top of rotary bushing.)

Red Rock	100'	Circ. for samples at 4365'
Red Rock	200'	4375'
Shale	950'	4385'
Shale & Shells	1385'	4395'
Shale, Shells & Lime	1685'	4455'
Lime	2490'	
Lime & Shale	2900'	
Shale	3035'	
Lime & Shale	3125'	
Lime	3380'	
Lime & Shale	3511'	
Sand & Shale	3640'	
Lime & Shale	3810'	
Lime	4375'	
Mississippi	4431'	
Lime	4455' T.D.	

S.L.M. at 1900 - O.K.
3100 - O.K.
4000 - O.K.

Slope Test at 2000 0° off
3000 0° off
4000 0° off

PLUGGING		
FILE	SEC 24 T 32 R 13W	
BOOK	PAGE 1	LINE 45

REC'D
STATE CORPORATION
DEC 11 1958
CONSERVATION DIVISION
Wichita, Kansas

The undersigned, C. W. Sebitts, Attorney-in-Fact for PICKRELL DRILLING COMPANY, hereby certifies in behalf of said Company, that the above is a true and correct log of the formation encountered in drilling the above well as reflected by the Daily Drilling Reports.

PICKRELL DRILLING COMPANY

By C. W. Sebitts
Attorney-in-Fact

STATE OF KANSAS }
COUNTY OF SEDGWICK } ss.:

On this 6th day of December, 1958, before me the undersigned, a Notary Public, in and for

the County and State aforesaid, personally appeared C. W. Sebitts, to me known to be the identical person who subscribed the name of PICKRELL DRILLING COMPANY to the foregoing instrument as its Attorney-in-Fact and acknowledged to me that he executed the same as his free and voluntary act and deed, and as the free and voluntary act and deed of such company, for the uses and purposes therein set forth.

Given under my hand and seal of office the day and year last above written.

My commission expires: May 13, 1962

Mary Ellen Sampson
Notary Public
(Mary Ellen Sampson)