

STATE OF KANSAS  
STATE CORPORATION COMMISSION


Give All Information Completely  
Make Required Affidavit  
Mail or Deliver Report to:  
Conservation Division  
State Corporation Commission  
211 No. Broadway  
Wichita, Kansas

WELL PLUGGING RECORD

*BIRKBEIL*

Barton County. Sec. 24 Twp. 32 Rge. 13 (E) W (W)

T - 32 NORTH R - 13W

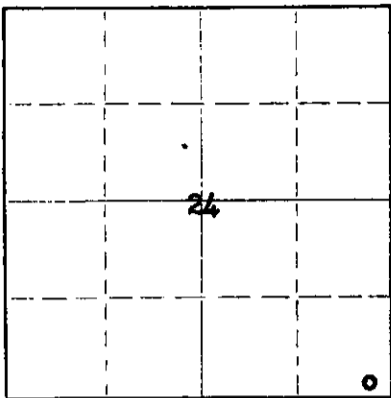

Locate well correctly on above Section Plat

Location as "NE/CNW/SW" or footage from lines SE SE SE  
Lease Owner Frank J. Black  
Lease Name E. T. Lonker Well No. 1  
Office Address McPherson, Kansas  
Character of Well (completed as Oil, Gas or Dry Hole) Oil  
Date well completed 5-4-55 19\_\_  
Application for plugging filed 3-14-62 19\_\_  
Application for plugging approved 3-16-62 19\_\_  
Plugging commenced 4-4-62 19\_\_  
Plugging completed 4-7-62 19\_\_  
Reason for abandonment of well or producing formation Depleted.

If a producing well is abandoned, date of last production \_\_\_\_\_ 19\_\_  
Was permission obtained from the Conservation Division or its agents before plugging was commenced? yes

Name of Conservation Agent who supervised plugging of this well Fred Hampel  
Producing formation \_\_\_\_\_ Depth to top \_\_\_\_\_ Bottom \_\_\_\_\_ Total Depth of Well 4550 Feet  
Show depth and thickness of all water, oil and gas formations.

OIL, GAS OR WATER RECORDS

CASING RECORD

FORMATION	CONTENT	FROM	TO	SIZE	PUT IN	PULLED OUT
				10-3/4"	345'	None
				5-1/2"	4550'	3115'

Describe in detail the manner in which the well was plugged, indicating where the mud fluid was placed and the method or methods used in introducing it into the hole. If cement or other plugs were used, state the character of same and depth placed, from \_\_\_\_\_ feet to \_\_\_\_\_ feet for each plug set.

Checked hole to 3800', set plug @ 3720', ran 30 gal. of sand to 3690' and dumped 5 sacks of cement @ 3690' with dump bailer. Pulled 5 1/2" casing, checked fluid to 290', set rockbridge to 280' and ran 30 sacks of cement @ 280'. Mudded to 125' then mudded from 125' to 35', set rock bridge to 30' and ran 15 sacks of cement to base of cellar.

**RECEIVED**  
STATE CORPORATION COMMISSION  
4-16-62  
1 1562  
CONSERVATION DIVISION

PLUGGING COMPLETE.

(If additional description is necessary, use BACK of this sheet)  
Name of Plugging Contractor Knight Casing Pulling Company  
Address Chase, Kansas

STATE OF Kansas, COUNTY OF Rice, ss.  
Noel J. Knight (employee of owner) or (~~owner or operator~~) of the above-described well, being first duly sworn on oath, says: That I have knowledge of the facts, statements, and matters herein contained and the log of the above-described well as filed and that the same are true and correct. So help me God.

(Signature) Noel J. Knight  
Chase, Kansas  
(Address)

SUBSCRIBED AND SWORN TO before me this 10th day of April, 1962

My commission expires May 20, 1964 Milton J. Volin Notary Public.



WELL LOG BUREAU—KANSAS GEOLOGICAL SOCIETY  
508 East Murdock, Wichita, Kansas


**COPY**

Company. SINCLAIR OIL & GAS CO.  
Farm. E. T. Lonker No. 1

SEC. 24 T. 32 R. 13W  
SE SE SE

Total Depth. 4550  
Comm. 4-19-55 Comp. 5-4-55  
Shot or Treated.  
Contractor. Barbour Drilling Co.  
Issued. 1-7-56

County Barber  
KANSAS

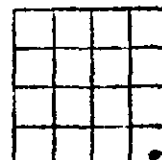

Elevation 1641 RB

Production. 155 BOPD, NW

CASING:

10 3/4 @ 345' w/ 250 sx cmt.  
5 1/2 @ 4550' w/ 250 sx cmt.

Figures indicate Bottom of Formations.

sand rock	35
sand & clay	90
red bed	348
red bed, shale & shells	1020
shale & shells	1075
shale & anhydrite	1320
shale & shells	1460
anhydrite & shale	1840
anhydrite & lime shells	1935
shale & lime	2155
lime	2180
lime & shale	2330
shale	2391
shale & lime	2515
shale	2855
shale & lime	3200
shale	3260
lime	3340
shale & lime	3475
lime	3560
lime & shale	3650
sand & shale	3720
shale & lime	3760
lime	3840
lime & shale	3890
lime	4329
shale & lime	4471
lime	4480
chert & lime	4524
lime	4550
Total Depth	

SCOUT TOPS:  
Douglas 3761  
Kansas City 3854  
Mississippi 4433

Core #1: 4434-4471

**RECEIVED**  
STATE CORPORATION COMMISSION

APR 13 1962

CONSERVATION DIVISION  
Wichita, Kansas