


Give All Information Completely
Make Required Affidavit
Mail or Deliver Report to:
Conservation Division
State Corporation Commission
211 No. Broadway
Wichita, Kansas

WELL PLUGGING RECORD

Barber County, Sec. 24 Twp. 32S Rge. 13W (E) (W)
SE SE NW

NORTH

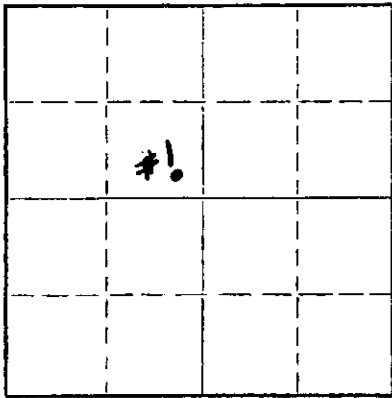

Locate well correctly on above
Section Plat

Location as "NE/CNWxSWx" or footage from lines _____
Lease Owner Sinclair Oil & Gas Company
Lease Name E. T. Lonker "A" Well No. 1
Office Address P. O. Box 521, Tulsa, Oklahoma
Character of Well (completed as Oil, Gas or Dry Hole) Dry Hole
Date well completed March 13, 19 56
Application for plugging filed March 13, 19 56
Application for plugging approved March 14, 19 56
Plugging commenced March 13, 19 56
Plugging completed March 13, 19 56
Reason for abandonment of well or producing formation Dry hole - no producing formation encountered.

If a producing well is abandoned, date of last production Dry hole. 19 _____

Was permission obtained from the Conservation Division or its agents before plugging was commenced? Yes - Verbal approval granted March 13, 1956

Name of Conservation Agent who supervised plugging of this well Mr. M. A. Rives, Box 8, Pratt, Kansas.

Producing formation None Depth to top _____ Bottom _____ Total Depth of Well 4590 Feet

Show depth and thickness of all water, oil and gas formations.

OIL, GAS OR WATER RECORDS

CASING RECORD

FORMATION	CONTENT	FROM	TO	SIZE	PUT IN	PULLED OUT
NONE				10-3/4"	276	None

Describe in detail the manner in which the well was plugged, indicating where the mud fluid was placed and the method or methods used in introducing it into the hole. If cement or other plugs were used, state the character of same and depth placed, from _____ feet to _____ feet for each plug set.

Mudded hole to 275'

Set Halliburton plug at 275'.

Dumped 25 sacks cement from 275 to 25'.

Set Halliburton plug at 25'.

Dumped 10 sacks cement from 25' to 0' (Surface)

Welded steel plate over surface casing.

(If additional description is necessary, use BACK of this sheet)

Name of Plugging Contractor Brack Drilling Company
Address 309-10 Brown Building, Wichita, Kansas.

STATE OF Kansas COUNTY OF Rice ss.
W. B. Rhee (employee of owner) or _____ of the above-described

well, being first duly sworn on oath, says: That I have knowledge of the facts, statements, and matters herein contained and the log of the above-described well as filed and that the same are true and correct. So help me God

(Signature) W B Rhee
P. O. Box 551, Chase, Kansas
(Address)

SUBSCRIBED AND SWORN to before me this 20 day of March, 19 56

My commission expires April 24 - 1956

RECEIVED
Notary Public.

PLUGGING
FILE SEC 24 T 32S R 13W
BOOK PAGE 45 LINE 21

MAR 21 1956
3-21-56
CONSERVATION DIVISION
Wichita, Kansas

BRACK DRILLING COMPANY, INC.
309-10 BROWN BUILDING
WICHITA 2, KANSAS

E. T. LONKER "A" No. 1 330' N from S line and
330' W from E line of

NW/4 Sec. 24-32S-13W
Barber County, Kansas
Commenced: 2-20-56
Completed: 3-13-56

TOTAL DEPTH: 4590'
ELEVATION: 1558' D.F.

WELL LOG

Surface Soil	0 -	5'
Sand, Red Bed, & Lime		80
Red Bed, Lime & Shells		277
Red Bed, Gyp, & Shells		775
Shale & Shells		1040
Shale, Sand, Lime & Shells		1605
Lime & Shale		1870
Lime		1962
Shale & Lime		2162
Lime & Shale		2267
Shale & Lime		2537
Lime & Shale		2585
Shale & Lime		2678
Lime & Shale		2930
Shale & Lime		2990
Lime & Shale		3054
Lime		3340
Lime & Shale		3390
Shale & Lime		3459
Lime		3522
Shale		3594
Shale & Lime		3656
Lime & Shale		3678
Sandy Shale		3744
Sandy Shale & Shale		3814
Sandy Shale & Lime		3820
Lime & Shale		3854
Lime		4199
Lime W/Shale Streaks		4229
Lime		4262
Lime & Shale		4339
Shale & Lime		4347
Mississippi Lime		4349
Core No. 1		4353
Core No. 2		4365
Core No. 3		4368
Core No. 4		4383
Mississippi Chert & Shale		4392
Mississippi Lime		4415
Mississippi Lime & Shale		4451
Lime & Shale		4478
Hard Lime		4483
Hard Lime & Chert		4501
Chert W/Lime Streaks		4521
Lime, Chert, & Shale		4588
Shale		4590' T.D. D. & A.

CASING

10 3/4" 276'

The above depths denote bottom of formations.

RECEIVED
CORPORATION COMMISSION
APR 20 1956
PLUGGING
FILE SEC. 24 T. 32 R. 13W
BOOK PAGE 45 LINE 21
CONSERVATION DIVISION
Wichita, Kansas

To the best of my knowledge, the above is a true and correct statement of the depths and formations and where found.

BRACK DRILLING COMPANY, INC.

By Bernard W. Green

March 15, 1956.

WITNESSED:

Arthur W. Crist