

15-007-08702-0000

WELL PLUGGING RECORD

Give All Information Completely
Make Required Affidavit
Mail or Deliver Report to:
Conservation Division
State Corporation Commission
211 No. Broadway
Wichita, Kansas

Barber County. Sec. 35 Twp. 33S Rge. 13 (E) (W) X

Location as "NE/CNWxSWx" or footage from lines NE NE NW

Lease Owner Continental Oil Company

Lease Name B. E. Holmes Well No. 1

Office Address P. O. Box 267 Great Bend, Kansas

Character of Well (completed as Oil, Gas or Dry Hole) _____

Date well completed _____ 19 _____

Application for plugging filed _____ 19 _____

Application for plugging approved _____ 19 _____


Plugging commenced 7-22-65 19 _____

Plugging completed 7-30-65 19 _____

Reason for abandonment of well or producing formation _____
Dry

If a producing well is abandoned, date of last production _____ 19 _____

Was permission obtained from the Conservation Division or its agents before plugging was commenced? Yes

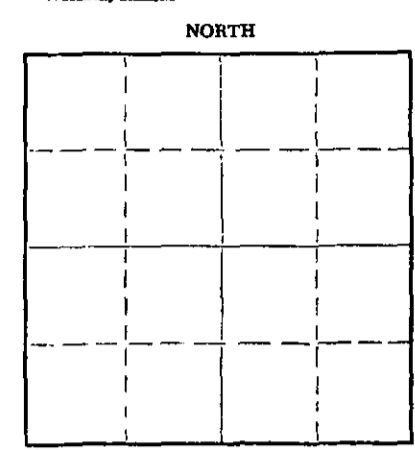

Locate well correctly on above Section Flat

Name of Conservation Agent who supervised plugging of this well Archie V. Elving

Producing formation _____ Depth to top _____ Bottom _____ Total Depth of Well 4514 Feet

Show depth and thickness of all water, oil and gas formations.

OIL, GAS OR WATER RECORDS

CASING RECORD

FORMATION	CONTENT	FROM	TO	SIZE	PUT IN	PULLED OUT
				13 3/8	320	None
				4 1/2	None	3621

Describe in detail the manner in which the well was plugged, indicating where the mud fluid was placed and the method or methods used in introducing it into the hole. If cement or other plugs were used, state the character of same and depth placed, from _____ feet to _____ feet for each plug set.

Moved in. Cleaned out cellar. Sanded to 4500'. Dumped 3 sacks of cement. Loaded hole with water. Working pipe.

Working pipe. Shot pipe at 3700' & 3605'. Pulling pipe.

Working pipe. Pulling pipe.

Pulling pipe. Bailing down hole- lost bailer in hole. Dumped 15 sacks of cement lost in hole.

Fishing out bailer. Pushed plug to 255'. Build 10' rock bridge. Dumped 15 sacks of cement.

Bailing. Dumped 35 sacks of cement. Filled hole and rock bridge. Capped well with 20 sacks of cement.

RECEIVED
STATE CORPORATION COMMISSION
AUG 6 - 1965
8-6-65
CONSERVATION DIVISION
Wichita, Kansas

(If additional description is necessary, use BACK of this sheet)

Name of Plugging Contractor Forbes Casing Pulling, Inc.
Address P. O. Box 221 Great Bend, Kansas

STATE OF Kansas COUNTY OF Barton, ss.
J. O. Forbes (employee of owner) or (owner or operator) of the above-described

well, being first duly sworn on oath, says: That I have knowledge of the facts, statements, and matters herein contained and the log of the above-described well as filed and that the same are true and correct. So help me God.

(Signature) J. O. Forbes
P. O. Box 221 Great Bend, Kansas
(Address)

SUBSCRIBED AND SWORN TO before me this 5 day of August, 1965

My commission expires May 27, 1969 Notary Public.

15-007-00702-0000

DRILLERS LOG

Holmes No. 1

CASING RECORD:	COMPANY:	Continental Oil Co.	DESCRIPTION:
13 3/8" @ 320' w/300 sx cement	CONTRACTOR:	Red Tiger Drilling Co.	NE NE NW 35-33S-13W Barber Co., Kansas
4 1/2" @ 4514' w/150 sx cement	COMMENCED:	September 18, 1963	ELEVATION: 1549 DF 1552 RB
TOTAL DEPTH: 5038'	COMPLETED:	October 14, 1963	

<u>FORMATION</u>	<u>FROM</u>	<u>TO</u>	<u>REMARKS</u>
Sand & Shale	0	60	
Shale, Shells & Red Bed	60	324	
Shale & Shells	324	550	
Shale	550	1000	
Shale & Shells	1000	1493	
Anhydrite	1493	1530	
Shale & Shells	1530	1595	
Shale & Lime	1595	3100	
Shale, Lime & Sand	3100	3305	
Lime & Shale	3305	3686	
Lime	3686	3705	
Lime & Shale	3705	3835	
Shale & Sand	3835	3920	
Lime	3920	3945	
Lime & Shale	3945	3979	
Lime	3979	4355	
Lime & Shale	4355	4405	
Lime	4405	4570	
Lime & Chert	4570	4626	
Lime	4626	4677	
Lime & Shale	4677	4820	
Lime	4820	4882	
Lime - Chalk	4882	4911	
Lime & Chert	4911	4985	
Lime & Shale	4985	4998	
Coring	4998	5038	

RECEIVED
 STATE CORPORATION COMMISSION
 JUL 9 1965
 7-9-65
 CONSERVATION DIVISION
 Wichita, Kansas

I certify that this is a true and correct copy of the above log to the best of my knowledge.

RED TIGER DRILLING COMPANY

George A. Angle

 George A. Angle

Subscribed and sworn to before me this 18th day of October, 1963.

Minnie V. Head

 Notary Public

My Commission Expires:

11-17-66