

STATE OF KANSAS
STATE CORPORATION COMMISSION


WELL PLUGGING RECORD

Give All Information Completely
Make Required Affidavit
Mail or Deliver Report to:
Conservation Division
State Corporation Commission
800 Bitting Building
Wichita, Kansas

Barber County, Sec. 33 Twp. 33S Rge. (E) 13 (W)

Location as "NE/CNWxSWx" or footage from lines Ctr SE/4 SE/4
Lease Owner Graham-Miller Oil Company
Lease Name Holmes "A" Well No. 1
Office Address 1005 East Second, Wichita, Kansas
Character of Well (completed as Oil, Gas or Dry Hole) Dry Hole
Date well completed March 9, 1955 19
Application for plugging filed March 9, 1955 (Verbal) 19
Application for plugging approved March 9, 1955 (Verbal) 19
Plugging commenced March 9, 1955 19
Plugging completed March 9, 1955 19
Reason for abandonment of well or producing formation Dry Hole

NORTH

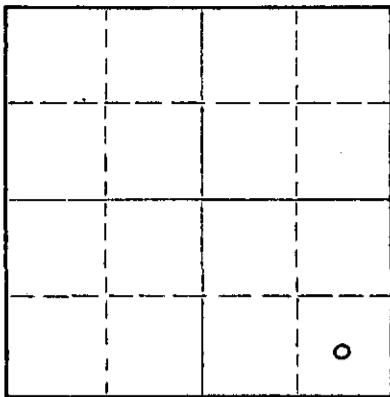

Locate well correctly on above
Section Plat

If a producing well is abandoned, date of last production -- 19
Was permission obtained from the Conservation Division or its agents before plugging was commenced? Yes

Name of Conservation Agent who supervised plugging of this well M. A. Rives, Box 8, Pratt, Kansas
Producing formation _____ Depth to top _____ Bottom _____ Total Depth of Well 5215 Feet
Show depth and thickness of all water, oil and gas formations.

OIL, GAS OR WATER RECORDS

CASING RECORD

FORMATION	CONTENT	FROM	TO	SIZE	PUT IN	PULLED OUT
				8 5/8"	330'	None

Describe in detail the manner in which the well was plugged, indicating where the mud fluid was placed and the method or methods used in introducing it into the hole. If cement or other plugs were used, state the character of same and depth placed, from _____ feet to _____ feet for each plug set.

Set bottom plug at 300' with
20 sacks cement and 1/2 sack
hulls. Filled hole to 35'
and ran plug. Set with 10
sacks cement and 1/3 sack hulls.

(If additional description is necessary, use BACK of this sheet)

Name of Plugging Contractor Graham-Messman-Rinehart Drilling Company
Address 1005 East Second, Wichita, Kansas

STATE OF Kansas, COUNTY OF Sedgwick, ss.

J. A. Gilliland (employee of owner) ~~not a competent person~~ of the above-described well, being first duly sworn on oath, says: That I have knowledge of the facts, statements, and matters herein contained and the log of the above-described well as filed and that the same are true and correct. So help me God.

(Signature) J. A. Gilliland

1005 East Second, Wichita, Kansas
(Address)

SUBSCRIBED AND SWORN TO before me this 15th day of March, 19 55

My commission expires November 5, 1958

Jessamine L. Lewis
Notary Public.

RECEIVED
STATE OF KANSAS
CONSERVATION DIVISION
Wichita, Kansas

PLUGGING
FILE SEC 33T 33S 13W
BOOK PAGE 103 LINE 14

NO. 1 HOLMES "A"

WELL RECORD

Location: Ctr SE/4 SE/4, 33-33S-13W
Barber County, Kansas

Commenced: February 17, 1955

Operator: Gramhart-Miller Oil Company
1005 East Second, Wichita, Kansas

Completed: March 9, 1955

Elevation: 1722 KB

Contractor: Graham-Messman-Rinehart Drlg. Co.
1005 East Second, Wichita, Kansas

Production: D&A

Casing Record: 8 5/8" @ 330' w/225 sacks cement

....L O G....

Sand-Clay	35
Red bed-shale	250
Shale-Shells	330
Shale-red bed	420
Shale	1220
Shale-Red Bed	1570
Shale-Shells	1900
Lime-Shale	2800
Shale	3125
Lime-Shale	3295
Shale	3425
Shale-Lime	3580
Lime-Shale	3631
Shale-Sand	3770
Shale	3892
Lime-Shale	3991
Shale-Sand	4050
Lime-Shale	4165
Lime-Chalk	4250
Lime	4287
Lime-Shale	4343
Lime	4399
Lime-Chert	4425
Lime	4524
Lime-Black Shale	4570
Lime	4683
Lime-Shale	4705
Lime	4786
Lime-Shale	4809
Lime	4953
Lime-Shale	5079
Lime	5111
Lime-Chert	5145
Lime-Chert-Shale	5188
Sand-Shale	5215 R.T.D.

Sample Tops

Heebner 3983 (-2261)
Douglas Sd 3993 (-2271)
Brn Lime 4154 (-2432)
Lansing 4161 (-2439)
Marmaton 4645 (-2923)
Mississippi 4714 (-2992)
Kinderhook Sh 4941 (-3219)
Chattanooga Sh 4990 (-3268)
Misener Sd 5048 (-3326)
Viola 5050 (-3328)
Simpson Sh 5163 (-3441)
Simpson Sd 5189 (-3467)

3-16-55

The undersigned, GRAHAM-MESSMAN-RINEHART DRILLING COMPANY, hereby certifies that the above log is a true and correct log of the formation encountered in drilling the above well as reflected by the Daily Drilling Report.

GRAHAM-MESSMAN-RINEHART DRILLING COMPANY

By: J. A. Gilliland

Subscribed and sworn to before me this 15th day of March 1955.

Jeranita L. Davis
Notary Public

My Commission Expires: November 5, 1958

PLUGGING
FILE NO. 33-33S-13W
BOOK PAGE 103 LINE 14