


WELL PLUGGING RECORD

Give All Information Completely
Make Required Affidavit
Mail or Deliver Report to:
Conservation Division
State Corporation Commission
800 Biting Building
Wichita, Kansas

NORTH

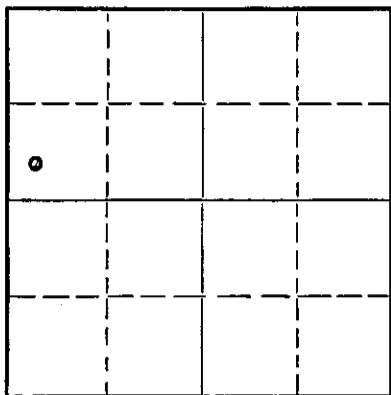

Locate well correctly on above Section Plat

BARBER County. Sec. 15 Twp. 308 Rge. 12 (S) (W) (NW)
Location as "NE/CNW $\frac{1}{4}$ SW $\frac{1}{4}$ " or footage from lines SW $\frac{1}{4}$ SW $\frac{1}{4}$ NW $\frac{1}{4}$
Lease Owner National Associated Petroleum Co.
Lease Name R.F. HOUSE Well No. 1
Office Address Ritz Bldg. Tulsa, Okla.
Character of Well (completed as Oil, Gas or Dry Hole) Dry Hole
Date well completed 3-27-51 19 51
Application for plugging filed October 22 19 51
Application for plugging approved October 22 19 51
Plugging commenced October 27 19 51
Plugging completed Nov. 7, 19 51
Reason for abandonment of well or producing formation Not commercially productive

If a producing well is abandoned, date of last production _____ 19 ____
Was permission obtained from the Conservation Division or its agents before plugging was commenced? Yes

Name of Conservation Agent who supervised plugging of this well G.D. Stough
Producing formation Viola Depth to top 4582 Bottom 4589 Total Depth of Well 4741 Feet
Show depth and thickness of all water, oil and gas formations.

OIL, GAS OR WATER RECORDS

CASING RECORD

Formation	Content	From	To	Size	Put In	Pulled Out
Lansing	Water	3861	4265	10-3/4"	281 ft.	None
Mississippi	Water	4265	4359	5"		3637.15 ft.
Viola	Oil	4482	4589			
Simpson	Water	4589	4691			
Arbuckle	Water	4691	4741			

Describe in detail the manner in which the well was plugged, indicating where the mud fluid was placed and the method or methods used in introducing it into the hole. If cement or other plugs were used, state the character of same and depth placed, from _____ feet to _____ feet for each plug set.

Put chat into the hole ---from 4490 ft. to 4290 ft.
Put in Rock ---from 4290 ft. to 4179 ft.
Mixed and dumped five (5) sacks of cement
Mudded hole with approved mud laden fluid.
Bailed out mud to bottom of surface pipe-----Then set a bridge.
Dumped 20 sacks of cement.
Mudded Hole to within 30 ft. of Top.-----Then Set a bridge.
Dumped 10 sacks of Cement.

RECEIVED
STATE CORPORATION COMMISSION
NOV 16 1951
CONSERVATION DIVISION
KANSAS

(If additional description is necessary, use BACK of this sheet)
Name of Plugging Contractor GENERAL CASING PULLING CO. (Okla. Corp Permit # 158)
Address P.O. Box 4387 1319 S.E. 29th St. Okla. City, Okla.

STATE OF Oklahoma COUNTY OF Tulsa, ss.
C. Edwin Mohler (employee of owner) or (owner or operator) of the above-described well,
being first duly sworn on oath, says: That I have knowledge of the facts, statements, and matters herein contained and the log of the above-described well as filed and that the same are true and correct. So help me God.

(Signature) C. Edwin Mohler, Chief Geologist
5th Floor Ritz Building - Tulsa, Oklahoma
(Address)

SUBSCRIBED AND SWORN TO before me this 15th day of November, 1951
Maxine M. Lewis
Notary Public.

FILE ST 15-30 RLW
BOOK PAGE 29

SW, SW, NW,
Section 15-30S-12W,
Barber County, Kansas

Drilled for: National Assoc. Petroleum
Drilled by: Beardmore Drilling Company

Casing Record:

8-5/8" 295' w/200 sacks
5-1/2" OD 4550' w/125 sacks

Drilling commenced: November 20, 1950.
Drilling completed: December 22, 1950.

Elevation-1810'	FORMATION	DEPTH
	Sand	85
	Shale - shells	235
	Shale	278
	Shale - shells	1765
	Lime - shale	3650
	Lime broken	3735
	Lime	3975
	Lime broken	4038
	Lime	4338
	Lime cherty	4357
	Lime	4403
	Lime - shale	4460
	Lime - shale	4484
	Cored	4489
	Lime	4589
	Cored	4602
	Sand - shale	4628
	Lime - shale	4635
	Sand - shale	4694
	Lime	4711 T. D.

Tops:

Mississippi Lime 4265
Arbuckle 4694

DST 4029-38
open 1 hr 15 min
BHP 1400#
Recov 150' Salt Water

DST 4484-89
open 1 hr
Recov 300' oil

DST 4291-95
open 1 hr 15 min
No. BHP
Recov 7' oil cut mud

DST 4589-94
open 1 hr 15 min

DST 4595-4602
Open 1 hr
Recov 810' Salt Water

DST 4333-38
open 1 hr
BHP 170#
Recov 15' mud

DST 4694-4706
Open 1 hr 15 min
Recov 120' salt water

DST 4480-84
Open 40 min
Recov 360' oil

RECEIVED
STATE CORPORATION COMMISSION
OCT 25 1951
CONSERVATION DIVISION
WICHITA, KANSAS

STATE OF KANSAS
COUNTY OF SEDGWICK

I, the undersigned, being duly sworn on oath, state that the above and within statement is a true and correct log and record of the well drilled on the location above-described, to the best of my knowledge and belief.

W. B. Beardmore

Subscribed and sworn to before me this 4th day of January, 1951.

My Commission Expires:
October 12, 1952.

PLUGGING
FILE SEC 15 T 20 R 1242
BOOK PAGE 119 LINE 15

Eshel Murray
Notary Public