

15-007-20481-00-00


STATE OF KANSAS
STATE CORPORATION COMMISSION

WELL PLUGGING RECORD

Give All Information Completely
Make Required Affidavit
Mail or Deliver Report to
Conservation Division
State Corporation Comm.
245 North Water
Wichita, KS 67202

Barber County. Sec. 14 Twp. 30S Rge. 12W E/W
Location as "NE/CNW1SW1" or footage from lines
C SW/4 SE/4

Lease Owner Gear Petroleum Company
Lease Name Thom Well No. 1
Office Address 1325 Vickers KSB&T Bldg., Wichita, Ks. 67202
Character of Well (Completed as Oil, Gas or Dry Hole) D & A

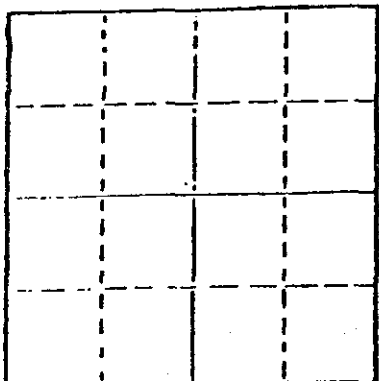

Locate well correctly on above
Section Plat

Date Well completed March 15, 1977
Application for plugging filed March 15, 1977
Application for plugging approved March 15, 1977
Plugging commenced March 15, 1977
Plugging completed March 15, 1977
Reason for abandonment of well or producing formation D & A

If a producing well is abandoned, date of last production 1977

Was permission obtained from the Conservation Division or its agents before plugging was commenced? Yes

Name of Conservation Agent who supervised plugging of this well J. H. Metz
Producing formation _____ Depth to top _____ Bottom _____ Total Depth of Well 3900

Show depth and thickness of all water, oil and gas formations.

OIL, GAS OR WATER RECORDS

CASING RECORD

FORMATION	CONTENT	FROM	TO	SIZE	PUT IN	PULLED OUT
				8 5/8"	281.12'	-0-

Describe in detail the manner in which the well was plugged, indicating where the mud plug was placed and the method or methods used in introducing it into the hold. If cement or other plugs were used, state the character of same and depth placed, from _____ feet to _____ feet for each plug set.

Plug hole w/mud to 240' & 35 sx cement
Mud to 40', 1/2 sx hulls, plug & 15 sx cement
5 sx cement in rathole

RECEIVED
STATE CORPORATION COMMISSION

MAR 28 1977

3-28-77

CONSERVATION DIVISION
Wichita, Kansas

(If additional description is necessary, use BACK of this sheet)

Name of Plugging Contractor Red Tiger Drilling Company
1720 KSB&T Building, Wichita, Kansas 67202


STATE OF Kansas COUNTY OF Sedgwick, ss. contractor
Gloria Fawcett (employee of ~~XXXXXX~~)

of the above-described well, being first duly sworn on oath, says: That I have knowledge of the facts, statements, and matters herein contained and the log of the above-described well as filed and that the same are true and correct. So help me God.

(Signature) Gloria Fawcett
1720 KSB&T Building, Wichita, Kansas 67202
(Address)

SUBSCRIBED AND SWORN TO before me this 22nd day of March, 1977.

My commission expires _____
Joyce A. Hagermann
Notary Public.

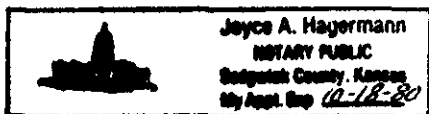

DRILLERS LOG

No. 1 Thom

CASING RECORD: 8 5/8" @ 288'
w/225 sx cmt.

COMPANY: Gear Petroleum Company

CONTRACTOR: Red Tiger Drilling Company

COMMENCED: March 7, 1977

COMPLETED: March 15, 1977

TOTAL DEPTH: 3,900'

DESCRIPTION: C SW/4 SE/4
Sec. 14-T30S-R12W
Barber County, Kansas

ELEVATION: 1,797' KB

<u>FORMATION</u>	<u>FROM</u>	<u>TO</u>	<u>REMARKS</u>
Sand	0	195	
Red Bed	195	465	
Red Bed & Shale	465	1190	
Shale w/Lime Stringers	1190	1685	
Shale	1685	1722	
Lime	1722	1870	
Shale & Lime	1870	2025	
Lime	2025	2965	
Lime & Shales	2965	3100	
Lime	3100	3745	
Shale & Lime	3745	3900	
RTD		3900	

RECEIVED
STATE COMMISSIONER
MAR 28 1977
CONSERVATION DIVISION
Wichita, Kansas

I certify that this is a true and correct copy of the above log to the best of my knowledge.

RED TIGER DRILLING COMPANY

Gloria Fawcett
Gloria Fawcett

Subscribed and sworn to before me this 22nd day of March, 1977.

Joyce A. Hagermann
Notary Public

