


STATE OF KANSAS
STATE CORPORATION COMMISSION

WELL PLUGGING RECORD

Give All Information Completely
Make Required Affidavit
Mail or Deliver Report to:
Conservation Division
State Corporation Commission
800 Bittling Building
Wichita, Kansas

NORTH

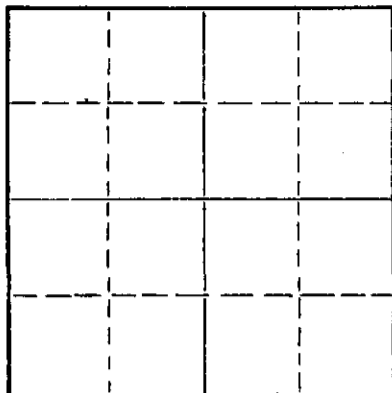

Locate well correctly on above
Section Plat

Barber County, Sec. 11 Twp. 30 Rge. 12 (E) W (W)
Location as "NE/CNW/SW" or footage from lines NE SE SE
Lease Owner Trans Era Petroleum, Inc.
Lease Name Sellers Well No. 1
Office Address Russell, Kansas
Character of Well (completed as Oil, Gas or Dry Hole) Dry Hole
Date well completed _____ 19____
Application for plugging filed 3/31/55 19____
Application for plugging approved 3/30/55 19____
Plugging commenced 3/31/55 19____
Plugging completed 3/31/55 19____
Reason for abandonment of well or producing formation Dry

If a producing well is abandoned, date of last production _____ 19____
Was permission obtained from the Conservation Division or its agents before plugging was commenced? Yes

Name of Conservation Agent who supervised plugging of this well M. A. Rives
Producing formation _____ Depth to top _____ Bottom _____ Total Depth of Well 4818 Feet
Show depth and thickness of all water, oil and gas formations.

OIL, GAS OR WATER RECORDS

CASING RECORD

FORMATION	CONTENT	FROM	TO	SIZE	PUT IN	PULLED OUT
				8 5/8"	265'	None

Describe in detail the manner in which the well was plugged, indicating where the mud fluid was placed and the method or methods used in introducing it into the hole. If cement or other plugs were used, state the character of same and depth placed, from _____ feet to _____ feet for each plug set.

PLUGGING RECORD

Filled hole with heavy mud to 265', set first plug at 265' with 15 sacks of cement mixed and run through drill pipe. Filled hole with mud to 40', set second plug with 10 sacks of cement used.

(If additional description is necessary, use BACK of this sheet)

Name of Plugging Contractor Trans Era Petroleum, Inc.
Address Russell, Kansas

STATE OF KANSAS, COUNTY OF RUSSELL, ss.
H. R. Michaelis (employee of owner) or (owner or operator) of the above-described well, being first duly sworn on oath, says: That I have knowledge of the facts, statements, and matters herein contained and the log of the above-described well as filed and that the same are true and correct. So help me God.

(Signature) [Signature]
Russell, Kansas
(Address)

SUBSCRIBED AND SWORN to before me this 7th day of April, 19 55

My commission expires 1-30-57

Margie Cooper
RECEIVED
STATE CORPORATION COMMISSION
Notary Public.

APR 13 1955
CONSERVATION DIVISION
Wichita, Kansas
PLUGGING
FILE SEC 11 T 30 R 12W
BOOK PAGE 108 LINE 43

Trans Era Petroleum, Inc.
Sellers #1

NW SE SE 11-30-12
Barber Co., Kansas

Total Depth: 4818'
Comm. 3/7/55
Comp. 3/31/55

Casing

Cement

8 5/8" set @ 265'

250 sacks Portland

FORMATION	DEPTH
Sand	155
Red bed-shale-shells	220
Shale	265
Red bed-shale	915
Shale-shells	1265
Shale-salt	1460
Shale-shells	1725
Lime	2010
Shale-lime	2260
Lime	2345
Lime-shale	2530
Lime-sand-shale	2636
Shale-lime	2737
Sand-shale	2822
Shale-lime	3230
Lime	3288
Shale-lime	3795
Sand-shale	3893
Lime	3941
Lime-shale	3976
Lime	4057
Lime-shale	4081
Lime	4193
Lime-shale	4255
Lime	4286
Lime-shale	4358
Mississippi Lime	4365
Lime-chert	4377
Chat-shale	4416
Lime-shale	4580
Viola	4585
Lime	4609
Lime-shale	4625
Viola lime	4657
Lime-Simpson sand	4661
Sand-shale	4690
Shale-sand-lime	4702
Sand-shale	4761
Shale	4795
Lime	4818'

STATE OF KANSAS)
) ss
RUSSELL COUNTY)

I hereby certify that the above information is true and correct to the best of my knowledge.

Coral Lutz

Subscribed and sworn to before me this 7th day of April, 1955.

RECEIVED
STATE CORPORATION COMMISSION
Margie Cooper
Notary Public

APR 12 1955

My commission expires: 1-30-57.

CONSERVATION DIVISION
Wichita, Kansas

PLUGGING
FILE SEC 11 T30 R 12w
BOOK PAGE 108 LINE 43