


WELL PLUGGING RECORD

Give All Information Completely  
Make Required Affidavit  
Mail or Deliver Report to:  
Conservation Division  
State Corporation Commission  
212 No. Market  
Wichita, Kansas

NORTH

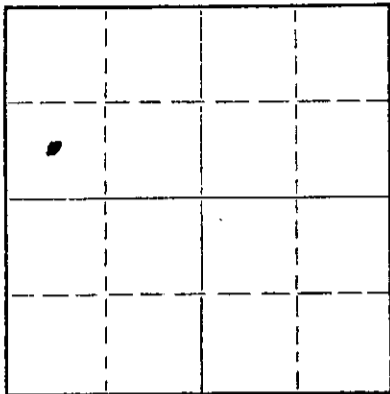

Locate well correctly on above Section Plat

Harper County, Sec. 7 Twp. 34 Rge. 8 (E) W (W)  
Location as "NE/CNW/SW" or footage from lines C SW NW  
Lease Owner Ferguson Oil Co.  
Lease Name Patterson Well No. 1  
Office Address 1505 Wichita Plaza, Wichita, Kansas  
Character of Well (completed as Oil, Gas or Dry Hole) Dry Hole  
Date well completed 5-12 19 68  
Application for plugging filed 5-12 19 68  
Application for plugging approved 5-12 19 68  
Plugging commenced 5-12 19 68  
Plugging completed 5-12 19 68  
Reason for abandonment of well or producing formation Dry Hole

If a producing well is abandoned, date of last production 19  
Was permission obtained from the Conservation Division or its agents before plugging was commenced? Yes

Name of Conservation Agent who supervised plugging of this well Archie V. Elving  
Producing formation Depth to top Bottom Total Depth of Well Feet  
Show depth and thickness of all water, oil and gas formations.

OIL, GAS OR WATER RECORDS

CASING RECORD

| FORMATION    | CONTENT | FROM | TO  | SIZE   | PUT IN | PULLED OUT |
|--------------|---------|------|-----|--------|--------|------------|
| Surface pipe |         | -0-  | 256 | 8 5/8" | 256    | -0-        |
|              |         |      |     |        |        |            |
|              |         |      |     |        |        |            |
|              |         |      |     |        |        |            |
|              |         |      |     |        |        |            |

Describe in detail the manner in which the well was plugged, indicating where the mud fluid was placed and the method or methods used in introducing it into the hole. If cement or other plugs were used, state the character of same and depth placed, from feet to feet for each plug set.

Filled hole with heavy mud.  
#1 plug @ 250' with 25 sks. cement.  
#2 plug @ 40' with 10 sks. cement.  
#3 plug in rat hole with 2 sks. cement.

RECEIVED  
STATE CORPORATION COMMISSION  
MAY 17 1968  
CONSERVATION DIVISION  
Wichita, Kansas


(If additional description is necessary, use BACK of this sheet)

Name of Plugging Contractor Sweetman Drilling, Inc.  
Address Box 645, Great Bend, Kansas 67530

STATE OF Kansas, COUNTY OF Barton, ss.  
T. D. Sweetman (employee of owner) or (owner or operator) of the above-described well, being first duly sworn on oath, says: That I have knowledge of the facts, statements, and matters herein contained and the log of the above-described well as filed and that the same are true and correct. So help me God.

(Signature) T. D. Sweetman  
Box 645, Great Bend, Kansas 67530  
(Address)

Subscribed and sworn to before me this 15 day of May, 1968

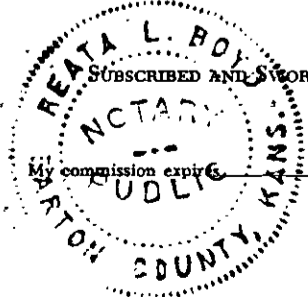

My commission expires 5-9-71

Reata L. Boyd  
Notary Public.

WELL LOG  
Patterson #1  
C SW NW 7-34-8W  
Harper County, Kansas

| FROM | TO   | Elevation: 1333 K.B. |
|------|------|----------------------|
| 0    | 565  | Red Bed              |
| 565  | 700  | Red Bed & Shale      |
| 700  | 1285 | Shale                |
| 1285 | 2130 | Lime & Shale         |
| 2130 | 2340 | Shale & Lime         |
| 2340 | 3340 | Lime & Shale         |
| 3340 | 3570 | Shale & Sand         |
| 3570 | 3776 | Shale & Lime         |
| 3776 | 3880 | Sand                 |
| 3880 | 4113 | Shale & Lime         |
| 4113 | 4342 | Lime                 |
| 4342 | 4573 | Lime & Shale         |
| 4573 | 4692 | Lime                 |
| 4692 | 4766 | Lime & Shale         |
| 4766 | 4984 | Shale                |
| 4984 | 5004 | Lime                 |
| 5004 | 5020 | Shale                |
| 5020 | 5061 | Sand                 |
| 5061 |      | Total Depth          |

STATE OF KANSAS

COUNTY OF BARTON ss

T. D. Sweetman, Partner of Sweetman Drilling, Inc., being first duly sworn on oath says: That I have knowledge of the facts, statements and matters herein contained and the log of the above described well as filed and that the same are true and correct.

T. D. Sweetman  
T. D. Sweetman

Subscribed and sworn before me this 14th day of May, 1968.

Leota J. Boyd  
Notary Public Barton County

