

STATE OF KANSAS
STATE CORPORATION COMMISSION

WELL PLUGGING RECORD

Give All Information Completely
Make Required Affidavit
Mail or Deliver Report to
Conservation Division
State Corporation Comm.
245 North Water
Wichita, KS 67202

Harper County, Sec. 4 Twp. 34 Rge. 8W E/W
Location as "NE/CNW $\frac{1}{4}$ SW $\frac{1}{4}$ " or footage from lines
SW NW SW


Lease Owner McCoy Petroleum Co.
Lease Name Bird Well No. 1
Office Address 816 Vickers KSB&T Bldg. Wichita, Ks. 67202
Character of Well (Completed as Oil, Gas or Dry Hole)
Dry Hole

Date Well completed 11-18 1976
Application for plugging filed 11-18 1976
Application for plugging approved 11-18 1976
Plugging commenced 11-18 1976
Plugging completed 11-18 1976
Reason for abandonment of well or producing formation

Dry Hole
If a producing well is abandoned, date of last production
19

Was permission obtained from the Conservation Division or
its agents before plugging was commenced? Yes

Name of Conservation Agent who supervised plugging of this well Russ Bieberstein
Producing formation Depth to top Bottom Total Depth of Well
Show depth and thickness of all water, oil and gas formations.

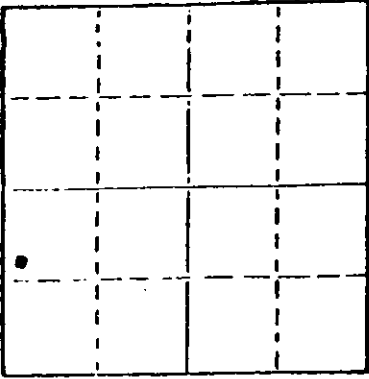

Locate well correctly on above
Section Plat

OIL, GAS OR WATER RECORDS

CASING RECORD

FORMATION	CONTENT	FROM	TO	SIZE	PUT IN	PULLED OUT
Surface pipe		-0-	221	8 5/8"	221	none

Describe in detail the manner in which the well was plugged, indicating where the mud fluid
was placed and the method or methods used in introducing it into the hold. If cement or other
plugs were used, state the character of same and depth placed, from _____ feet to
_____ feet for each plug set.

Filled hole with heavy mud.
#1 plug set @ 200' with 30 sks. cement.
#2 plug set @ 40' with 15 sks. cement.
#3 plug set in rat hole with 5 sks. cement.

RECEIVED
STATE CORPORATION COMMISSION
NOV 29 1976
11-29-76
CONSERVATION DIVISION
Wichita, Kansas

(If additional description is necessary, use BACK of this sheet)

Name of Plugging Contractor Sweetman Drilling, Inc.

STATE OF Kansas COUNTY OF Barton, ss.
Gary Hawk (employee of owner) or (owner or operator)


of the above-described well, being first duly sworn on oath, says: That I have knowledge of
the facts, statements, and matters herein contained and the log of the above-described well
as filed and that the same are true and correct. So help me God.

(Signature) Gary Hawk
Box 645 Great Bend, Kansas 67530
(Address)

SUBSCRIBED AND SWORN TO before me this 24th day of November, 1976

Mary Ann Schwamborn
Notary Public.

My commission expires 7-10-77

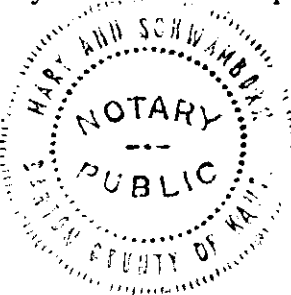

WELL LOG
Bird #1
SW NW SW 4-34-8W
Harper County, Kansas

Name of Operator: McCoy Petroleum Co.
816 Vickers KSB&T Bldg.
Wichita, Kansas 67202

Date Completed: November 18, 1976

<u>FROM</u>	<u>TO</u>	
0	920	Red bed and shale
920	1285	Shale
1285	3805	Lime and shale
3805	4620	Lime
4620	4666	Miss.
4666		Total Depth

RECORDED
NOV 29 1976

COMM. MATCH BY S. CH.
Wichita, Kansas

STATE OF KANSAS

COUNTY OF BARTON ss

Gary L. Hawk, Secretary of Sweetman Drilling, Inc., being first duly sworn on oath says: That I have knowledge of the facts, statements and matters herein contained and the log of the above described well as filed and that the same are true and correct.

Gary L. Hawk
Gary L. Hawk

Subscribed and sworn before me this 24th day of November, 1976

Mary Ann Schwaborn
Notary Public Barton County

My Commission Expires 7-10-77

