


STATE OF KANSAS
STATE CORPORATION COMMISSION

Give All Information Completely
Make Required Affidavit
Mail or Deliver Report to:
Conservation Division
State Corporation Commission
212 No. Market
Wichita, Kansas

WELL PLUGGING RECORD

NORTH

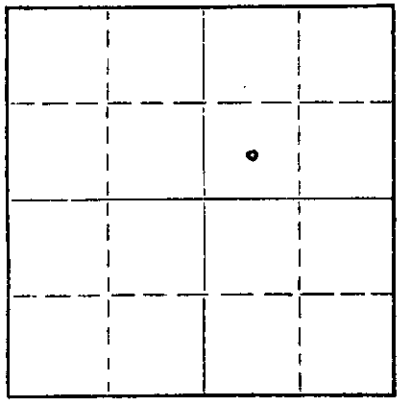

Locate well correctly on above Section Plat

Harper County. Sec. 3 Twp. 34S Rge. (E) 8 (W)
Location as "NE/CNW/SW" or footage from lines G SW NE
Lease Owner Shenandoah Oil Corporation
Lease Name James Wharton Well No. 1
Office Address 1018 Commerce Building, Ft. Worth, Texas
Character of Well (completed as Oil, Gas or Dry Hole) Oil Well
Date well completed 19
Application for plugging filed January 14, 19 70
Application for plugging approved January 16, 19 70
Plugging commenced February 26, 19 70
Plugging completed February 28, 19 70
Reason for abandonment of well or producing formation Non - commercial
If a producing well is abandoned, date of last production 19
Was permission obtained from the Conservation Division or its agents before plugging was commenced? Yes

Name of Conservation Agent who supervised plugging of this well
Producing formation Mississippi Depth to top 4643 Bottom 4667 Total Depth of Well 5079' Feet
Show depth and thickness of all water, oil and gas formations.

OIL, GAS OR WATER RECORDS

CASING RECORD

FORMATION	CONTENT	FROM	TO	SIZE	PUT IN	PULLED OUT
				8-5/8"	322'	None
				4-1/2"	4785'	3821.92'

Describe in detail the manner in which the well was plugged, indicating where the mud fluid was placed and the method or methods used in introducing it into the hole. If cement or other plugs were used, state the character of same and depth placed, from _____ feet to _____ feet for each plug set.

A 10 sack cement plug was pumped to 4520 feet with mud laden fluid. Pipe was shot free at 3811 feet and pulled. A 100 sack cement plug was pumped from 300 feet to surface.

RECEIVED
STATE CORPORATION COMMISSION
MAR 18 1970
CONSERVATION DIVISION
Wichita, Kansas

Name of Plugging Contractor Clyde A. Reeves & Son, Inc. (If additional description is necessary, use BACK of this sheet)
Address P. O. Box 94204, Oklahoma City, Oklahoma

STATE OF Texas COUNTY OF Tarrant ss.
R. L. Nabbefeld (employee of owner) or (owner or operator) of the above-described well, being first duly sworn on oath, says: That I have knowledge of the facts, statements, and matters herein contained and the log of the above-described well as filed and that the same are true and correct. So help me God.

(Signature) [Signature]
1500 Commerce Bldg., Fort Worth, Texas 76102
(Address)

SUBSCRIBED AND SWORN TO before me this 12th day of March, 19 70

My commission expires 6-1-71
Carnie L. Bulmer
Notary Public.