


WELL PLUGGING RECORD

Give All Information Completely
Make Required Affidavit
Mail or Deliver Report to:
Conservation Division
State Corporation Commission
211 No. Broadway
Wichita, Kansas

Harper County, Sec. 3 Twp. 34S Rge. 8W (E) (W)

Location as "NE/CNW%SW%" or footage from lines C SW SW
Lease Owner W. C. Pickens
Lease Name Halbower Well No. 1
Office Address 2000 Fidelity Union Tower, Dallas, Texas
Character of Well (completed as Oil, Gas or Dry Hole) Dry Hole
Date well completed 11-19-66 19
Application for plugging filed 11-19-66 19
Application for plugging approved 11-19-66 19
Plugging commenced 11-19-66 19
Plugging completed 11-19-66 19
Reason for abandonment of well or producing formation Dry Hole

NORTH

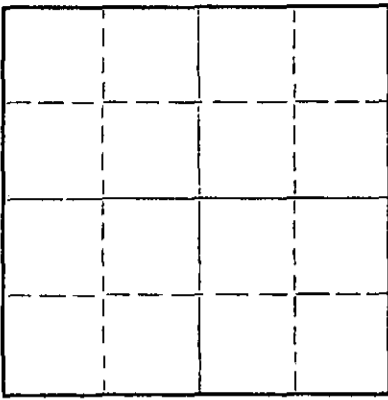

Locate well correctly on above
Section Plat

If a producing well is abandoned, date of last production 19
Was permission obtained from the Conservation Division or its agents before plugging was commenced? yes

Name of Conservation Agent who supervised plugging of this well Archie Elving, Pratt, Kansas
Producing formation Depth to top Bottom Total Depth of Well 5060 Feet
Show depth and thickness of all water, oil and gas formations.

OIL, GAS OR WATER RECORDS

CASING RECORD

FORMATION	CONTENT	FROM	TO	SIZE	PUT IN	PULLED OUT
				8 5/8"	270'	none

Describe in detail the manner in which the well was plugged, indicating where the mud fluid was placed and the method or methods used in introducing it into the hole. If cement or other plugs were used, state the character of same and depth placed, from feet to feet for each plug set.

Mud to 260' - 2 sacks cem. - set plug - 1/2 sk. hulls - 25 sks. cem.
Mud to 40' - 1 sack cem. - set plug - 1/2 sk. hulls - 10 sks. cem.
2 sacks cement in rathole

RECEIVED
STATE CORPORATION COMMISSION

NOV 28 1966

CONSERVATION DIVISION
Wichita, Kansas

(If additional description is necessary, use BACK of this sheet)

Name of Plugging Contractor Leben Drilling, Inc.
Address Box 486, Great Bend, Kansas 67530

STATE OF KANSAS, COUNTY OF BARTON, ss.
Leslie Kite (employee of owner) or (owner or operator) of the above-described well, being first duly sworn on oath, says: That I have knowledge of the facts, statements, and matters herein contained and the log of the above-described well as filed and that the same are true and correct. So help me God.

(Signature) Leslie Kite
P. O. Box 486, Great Bend, Kansas 67530
(Address)

SUBSCRIBED AND SWORN TO before me this 23rd day of November, 1966

My commission expires April 1, 1967 Ulanda Nichols Notary Public.

