


STATE OF KANSAS
STATE CORPORATION COMMISSION
CONSERVATION DIVISION
P. O. BOX 17027
WICHITA, KANSAS 67217

WELL PLUGGING RECORD

Barber County, Sec 2 Twp 33 Rge 13 (E) W(W)
Location as "NE/CNW/SW" or footage from lines C NE NW
Lease Owner K & E Drlg, Inc. ; Wichita, Ks. 67202
Lease Name Warwick Well No. 2
Office Address 719 Union Center Building
Character of Well (completed as Oil, Gas or Dry Hole)
Date well completed 1974
Application for plugging filed September 1974
Application for plugging approved September 1974
Plugging commenced September 23 1974
Plugging completed September 27 1974
Reason for abandonment of well or producing formation

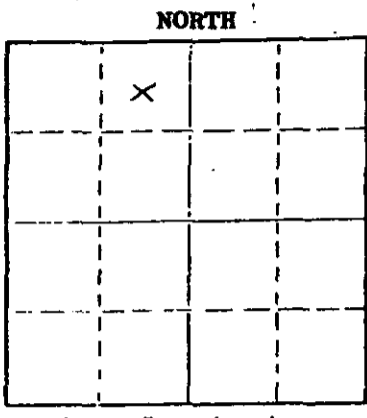

Locate well correctly on above Section Plot

If a producing well is abandoned, date of last production 1974
Was permission obtained from the Conservation Division or its agents before plugging was commenced? Yes

Name of Conservation Agent who supervised plugging of this well Russell Biberstein
Producing formation Depth to top Bottom Total Depth of Well Feet
Show depth and thickness of all water, oil and gas formations.

OIL, GAS OR WATER RECORDS

CASING RECORD

FORMATION	CONTENT	TO	SIZE	PUT IN	PULLED OUT
	RECEIVED FROM STATE CORPORATION COMMISSION		8 5/8"	254	None
			5 1/2"	4499	3594
	OCT 18 1974 10-18-74 CONSERVATION DIVISION Wichita, Kansas				

Describe in detail the manner in which the well was plugged, indicating where the mud fluid was placed and the method or methods used in introducing it into the hole. If cement or other plugs were used, state the character of same and depth placed, from feet to feet for each plug set.


September 23, 1974 Plugged off bottom. Dumped sand to 4300'. Mixed and dumped 5 sx of cement.
September 27, 1974 Plugged off top. Set 10' rock bridge at 240'. Filled 8 5/8" surface casing from 240' to base of cellar with 3000 lb. P.S.I. ready-mix concrete.

(If additional description is necessary, use BACK of this sheet)
Name of Plugging Contractor RUSS CASING PULLING, INC.
Address P. O. Box 1082 ; Great Bend, Kansas 67530

STATE OF KANSAS COUNTY OF SEDGWICK ss.
WAYNE L. BRINEGAR (employee of owner) or (owner or operator) of the above-described well, being first duly sworn on oath, says: That I have knowledge of the facts, statements, and matters herein contained and the log of the above-described well as filed and that the same are true and correct. So help me God.

(Signature) Wayne L. Brinegar
816 Union Center, Wichita, Kansas 67202
(Address)

REMEMBERED AND SWORN TO before me this 17th day of October, 1974
December 28, 1977

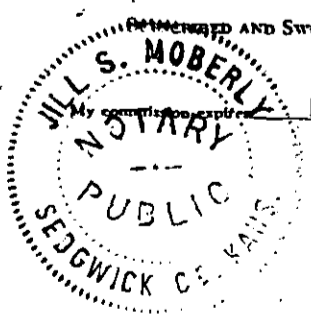

Jill S. Moberly
Notary Public

DRILLER'S WELL LOG

OPERATOR: K & E DRILLING, INC., et.al
719 Union Center Building
Wichita 2, Kansas

WELL NAME: #2 WARWICK
LOCATION: C NE NW
Section 2-33S-13W
Barber County, Kansas

CONTRACTOR: **K&E DRILLING, INC.**
719 UNION CENTER BLDG.
WICHITA, KANSAS

COMMENCED: 3-23-63

CASING RECORD: 8-5/8" @ 264' w/200 sx
5-1/2" @ 4494' w/150 sx.

COMPLETED: 4-1-63

ELEVATION: 1629 Gr.
1638 K.B.

ROTARY TOTAL DEPTH: 4495'

PRODUCTION: Yes-Mississippian

FORMATION RECORD

Depths shown indicate bottom of formations encountered.

Red Bed	75
Red Bed & Sand	250
Red Bed & Shells	1040
Red Bed	1225
Shale & Shells	1505
Lime & Shale	1785
Lime	2157
Lime & Shale	2310
Lime	2650
Lime & Shale	3849
Shale	3917
Lime	3965
Lime	4495'

RECEIVED
STATE CORPORATION COMMISSION
SEP 13 1974
9-13-74
CONSERVATION DIVISION
Wichita, Kansas

CERTIFICATION

State of KANSAS }
County of SEDGWICK } ss:

I, Wayne L. Brinegar, of K&E DRILLING, INC., upon oath state that the above and foregoing is a true and correct copy of the Driller's Log of the above named well.

Wayne L. Brinegar
Wayne L. Brinegar

Subscribed and sworn to before me this 4th day of April, 19 63.

Julene M. Bannon
Julene M. Bannon Notary Public.

My Commission expires: August 30, 1965

