


WELL PLUGGING RECORD

Give All Information Completely
Make Required Affidavit
Mail or Deliver Report to:
Conservation Division
State Corporation Commission
211 No. Broadway
Wichita, Kansas

Barber County, Sec. 35 Twp. 34S Rge. 13 (E) W (W)
Location as "NE/CNW/SW" or footage from lines CNW NE
Lease Owner Alamo Corporation
Lease Name Sterling Well No. 1
Office Address Box 985 Liberal, Kansas
Character of Well (completed as Oil, Gas or Dry Hole) Dry hole
Date well completed December 4, 1957 19
Application for plugging filed December 4, 1957 19
Application for plugging approved December 4, 1957 by phone 19
Plugging commenced December 4, 1957 19
Plugging completed December 4, 1957 19
Reason for abandonment of well or producing formation No commercial formations encountered
If a producing well is abandoned, date of last production _____ 19
Was permission obtained from the Conservation Division or its agents before plugging was commenced? Yes

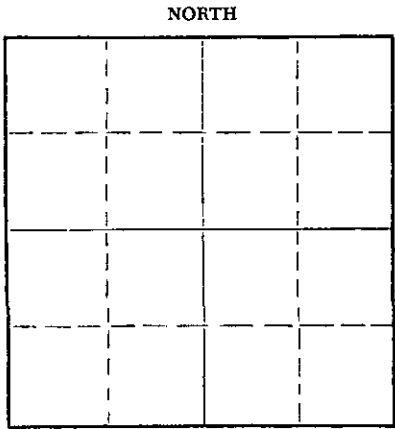

Locate well correctly on above Section Plat

Name of Conservation Agent who supervised plugging of this well M. A. Rives
Producing formation None Depth to top _____ Bottom _____ Total Depth of Well 3659 Feet
Show depth and thickness of all water, oil and gas formations.

OIL, GAS OR WATER RECORDS

CASING RECORD

FORMATION	CONTENT	FROM	TO	SIZE	PUT IN	PULLED OUT
				8-5/8	307	None

Describe in detail the manner in which the well was plugged, indicating where the mud fluid was placed and the method or methods used in introducing it into the hole. If cement or other plugs were used, state the character of same and depth placed, from _____ feet to _____ feet for each plug set.
Heavy mud to 300 feet. Plug at 300 feet with 1 1/2 gallons hulls ahead. 20 sacks cement displaced through drill pipe on top of plug; heavy mud to 35 feet. Plug hung on wire at 35 feet; 1/3 sack hulls on top plug, 10 sacks cement cap.

RECEIVED
STATE CORPORATION COMMISSION
DEC 7 1957
CONSERVATION DIVISION
WICHITA, KANSAS

(If additional description is necessary, use BACK of this sheet)
Name of Plugging Contractor Garvey Drilling
Address Wichita, Kansas

STATE OF Kansas, COUNTY OF Leward, ss.
_____, (employee of owner) or (owner or operator) of the above-described well, being first duly sworn on oath, says: That I have knowledge of the facts, statements, and matters herein contained and the log of the above-described well as filed and that the same are true and correct. So help me God.

(Signature) Edwin P. Thomas
Box 985, Liberal, Kansas
(Address)

SUBSCRIBED AND SWORN TO before me this 6 day of December, 1957

My commission expires March 30, 1961
Mary Lane Notary Public.

PLUGGING
FILE SEC 35T 34 R 13W
BOOK PAGE 67 LINE 38