

STATE OF KANSAS  
STATE CORPORATION COMMISSION

WELL PLUGGING RECORD

Give All Information Completely  
Make Required Affidavit  
Mail or Deliver Report to:  
Conservation Division  
State Corporation Commission  
800 Bitting Building  
Wichita, Kansas

Barber County, Sec. 16 Twp. 30 Rge. (E) 13(W)

Location as "NE/CNW4SW4" or footage from lines. SE SE SE

Lease Owner The Bay Petroleum Corporation

Lease Name J.J. Well No. 1

Office Address Box 513, Chase Kansas

Character of Well (completed as Oil, Gas or Dry Hole) Dry Hole

Date well completed Feb. 14 19 53

Application for plugging filed April 27 19 53

Application for plugging approved April 28 19 53


Plugging commenced April 30 19 53

Plugging completed May 5 19 53

Reason for abandonment of well or producing formation Dry Hole

If a producing well is abandoned, date of last production None 19    

Was permission obtained from the Conservation Division or its agents before plugging was commenced? Yes

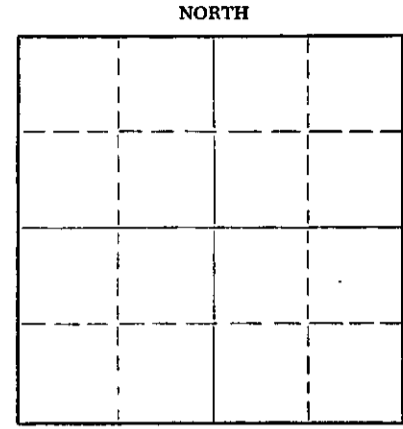

Locate well correctly on above Section Plat

Name of Conservation Agent who supervised plugging of this well Merle Rives

Producing formation \_\_\_\_\_ Depth to top \_\_\_\_\_ Bottom \_\_\_\_\_ Total Depth of Well 4728 Feet

Show depth and thickness of all water, oil and gas formations.

OIL, GAS OR WATER RECORDS

CASING RECORD

FORMATION	CONTENT	FROM	TO	SIZE	PUT IN	PULLED OUT
				5 1/2"	4728'	3996'
				8 5/8"	608'	None
				13 3/8"	49'	None

Describe in detail the manner in which the well was plugged, indicating where the mud fluid was placed and the method or methods used in introducing it into the hole. If cement or other plugs were used, state the character of same and depth placed, from \_\_\_\_\_ feet to \_\_\_\_\_ feet for each plug set.

Rocked hole from 4350' to 4300' and ran 5 sacks of cement. Mudded hole from 4240' to 300', set 10' rock bridge and ran 20 sacks of cement. Mudded hole to 35', set rock bridge and ran 10 sacks of cement. Plugging completed

(If additional description is necessary, use BACK of this sheet)

Name of Plugging Contractor West Supply Co  
Address Chase Kansas

STATE OF Kansas, COUNTY OF Barber, ss.  
Glen E. Armour (employee of owner) of Barber of the above-described well, being first duly sworn on oath, says: That I have knowledge of the facts, statements, and matters herein contained and the log of the above-described well as filed and that the same are true and correct. So help me God.

(Signature) Glen E. Armour

(Address)

SUBSCRIBED AND SWORN TO before me this 13 day of May, 19 53

My commission expires May 20 1954

24-2675-B 2-52-20M

Clement O. Gray Notary Public.

STATE CORPORATION COMMISSION

MAY 15 1953

CONSERVATION DIVISION  
Wichita, Kansas

**PLUGGING**  
FILE SEC 16 T 30 R 13W  
BOOK PAGE 97 LINE 4

**ROTARY DRILLING LOG**

COMPANY: **Bay Petroleum Corporation**

Rotary Drilling Commenced 12/11/52

LOCATION: **SE SE SE, 16-30S-13W, Barber County, Kansas**      **J-J #1**

Rotary Drilling Completed 1/9/53

CONTRACTOR: **PICKRELL DRILLING COMPANY, Wichita, Kansas**

CASING RECORD: **49.84' of 13 3/8" cemented with 50 sacks and 140 sacks.**  
**20 Jts (608') 8 5/8" 2 1/4" cemented with 125 sacks and 160 sacks.**  
**150 Jts (4728') of 5 1/2" J-55 1 1/4" casing cemented with 100 sacks.**

**LOG**

(Figures indicate bottom of formation - measurements from top of rotary bushing.)

Sand & Clay	50	Circ for Sample at	3571
Red Bed	748	" " "	3676
Anhydrite	765	" " "	3800'
Red Bed & Shale	965	" " "	3810
Shale & Shells	1450	" " "	3968
Salt & Shale	1550	" " "	3983
Shale & Shells	1650	" " "	4317
Shale & Salt	1940	" " "	4336
Shale & Shells	1965	" " "	4363
Lime & Shale	2190	" " "	4367
Lime	2285	" " "	4507
Lime & Shale	2300	" " "	4528
Shale & Shells	2460	" " "	4555
Shale & Shells Stks of Lime	2560	" " "	4660
Shale	2640	" " "	4668
Shale & Shells	2810	" " "	4675
Shale Lime	2965	" " "	4680
Shale & Lime	3121	" " "	4682
Lime	3214	" " "	4688
Shale & Lime	3245	" " "	4693
Lime	3727	" " "	4698
Lime & Shale	3800	" " "	4702
Lime & Shale Stks of Sand	3860	" " "	4707
Lime	4336	" " "	4728
Lime & Shale	4367		
Lime	4378	Slope Test at 2000'	0° off
Lime - Cherty	4417	" " "	2900' " "
Lime	4445		
Lime & Shale	4528	S.L.M. - OK	
Lime	4606		
Simpson Shale	4675		
Shale	4680		
Arbuckle	4728		

**RECEIVED**  
**R.T.D. DIVISION**  
**COMMISSION**

The undersigned, C. W. Sobits, Attorney-in-Fact for PICKRELL DRILLING COMPANY, hereby certifies in behalf of said Company, that the above is a true and correct log of the formation encountered in drilling the above well as reflected by the Daily Drilling Reports.

PICKRELL DRILLING COMPANY  
 By [Signature]  
 Attorney-in-Fact

STATE OF KANSAS, }  
 COUNTY OF SEDGWICK } ss.:

**DRILLING**  
**FILE SEC - T - R**  
**BOOK PAGE - LINE**

On this 26th day of January, 19 53, before me the undersigned, a Notary Public, in and for

the County and State aforesaid, personally appeared C. W. Sobits, to me known to be the identical person who subscribed the name of PICKRELL DRILLING COMPANY to the foregoing instrument as its Attorney-in-Fact and acknowledged to me that he executed the same as his free and voluntary act and deed, and as the free and voluntary act and deed of such company, for the uses and purposes therein set forth.

Given under my hand and seal of office the day and year last above written.

[Signature]  
 Notary Public

My commission expires: January 28, 1953