


### WELL PLUGGING RECORD

Give All information Completely  
Make Required Affidavit  
Mail or Deliver Report to:  
Conservation Division  
State Corporation Commission  
800 Bitting Building  
Wichita, Kansas

Barber County. Sec. 15 Twp. 30 Rge. 13 (E) W (W)  
Location as "NE/CNW $\frac{1}{4}$ SW $\frac{1}{4}$ " or footage from lines SE-SE-SW  
Lease Owner Hall-Jones  
Lease Name Grigsby Well No. 1  
Office Address Box 1100 - Oklahoma City, Oklahoma  
Character of Well (completed as Oil, Gas or Dry Hole) Abandon  
Date well completed 12-18-54 19  
Application for plugging filed 12-18-54 19  
Application for plugging approved 12-18-54 19  
Plugging commenced 12-18-54 19  
Plugging completed 12-18-54 19  
Reason for abandonment of well or producing formation Abandon - Location  
on Wrong Location  
If a producing well is abandoned, date of last production 19  
Was permission obtained from the Conservation Division or its agents before plugging was commenced? Yes

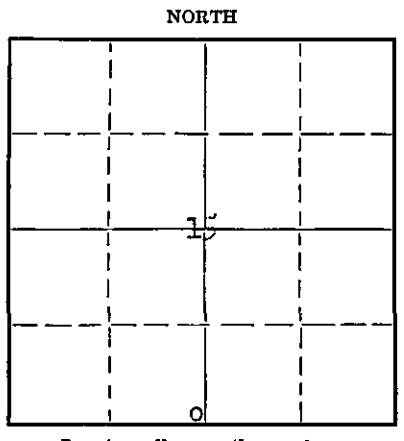

Locate well correctly on above  
Section Plat

Name of Conservation Agent who supervised plugging of this well Merle Rives  
Producing formation - Depth to top - Bottom - Total Depth of Well 381 ft  
Show depth and thickness of all water, oil and gas formations.

#### OIL, GAS OR WATER RECORDS

#### CASING RECORD

Formation	Content	From	To	Size	Put In	Pulled Out

Describe in detail the manner in which the well was plugged, indicating where the mud fluid was placed and the method or methods used in introducing it into the hole. If cement or other plugs were used, state the character of same and depth placed, from \_\_\_\_\_ feet to \_\_\_\_\_ feet for each plug set.

Billed hole with heavy mud Bridged hole 210ft., cemented with 20 sacks,  
Filled hole and bridged at 35 Ft., cemented 10 sacks to top of cellar.

(If additional description is necessary, use BACK of this sheet)

Correspondence regarding this well should be addressed to S. A. Berwick Drilling Company  
Address 1105 Williams, Great Bend, Kansas

STATE OF KANSAS, COUNTY OF BARTON, ss.

(employee of owner) or (owner or operator) of the above-described well,  
being first duly sworn on oath, says: That I have knowledge of the facts, statements, and matters herein contained and the log of the above-described well as filed and that the same are true and correct. So help me God.

(Signature) *S. A. Berwick*  
1105 Williams, Great Bend, Kansas  
(Address)

SUBSCRIBED AND SWORN to before me this 3rd day of January, 1955  
*Jayman* Notary Public.

My commission expires April 11, 1955 23-5091-3 8-50-10M

**PLUGGING**  
FILE SEC 15 T 30 R 13W  
BOOK PAGE 86 LINE 2

JAN 15 1955  
CONS...  
WICHITA, KS

S. A. BERWICK - BROOKS HALL  
1105 Williams  
Great Bend, Kansas

Grigsby #1

Total Depth: 3814'  
Commenced R. D.: 12-10-54  
Completed R. D.: 12-18-54

SE-SE-SW Sec. 15-30-13W  
Barber County, Kansas  
Elevation:  
Initial Prod.:  
Contractor: S. A. Berwick  
Drilling Co.

Strata	Depth
Surface Soil and Sand	0- 60
Shale and Red Bed	60- 212
Shale	212- 340
Sand and Shale	340- 430
Shale and Shells	430-1080
Lime	1080-1105
Red Bed and Shale	1105-1550
Shale and Shells	1550-1835
Lime and Shale	1835-2200
Shale	2200-2285
Lime and Shale	2285-3085
Lime	3085-3160
Shale and Lime	3160-3330
Sand	3330-3355
Lime	3355-3470
Lime and Shale	3470-3814

I hereby certify the above a true and correct log of said well as reflected by the daily drilling report.

S. A. BERWICK DRILLING COMPANY

By S. A. Berwick

Signed and sworn to in my presence this 8th day of January, 1955, by S. A. Berwick, owner of the S. A. Berwick Drilling Company.

John W. Jones  
Notary Public

My Commission Expires: April 11, 1955

