

STATE OF KANSAS
STATE CORPORATION COMMISSION

WELL PLUGGING RECORD

Give All Information Completely
Make Required Affidavit
Mail or Deliver Report to
Conservation Division
State Corporation Comm.
245 North Water
Wichita, KS 67202

Barber County, Sec. 15 Twp. 30W Rge. 13WE/W
Location as "NE/CNW $\frac{1}{4}$ SW $\frac{1}{4}$ " or footage from lines
SW SE/ SW


Lease Owner National Oil Company
Lease Name Grigsby "A" #1 Well No.
Office Address Suite 550, 200 W. Douglas, Wichita, KS
Character of Well (Completed as Oil, Gas or Dry Hole)
dry

Date Well completed April 11, 1979 19
Application for plugging filed April 11, 1979 19
Application for plugging approved April 11, 1979 19
Plugging commenced April 11, 1979 19
Plugging completed April 11, 1979 19
Reason for abandonment of well or producing formation
dry

If a producing well is abandoned, date of last production
19

Was permission obtained from the Conservation Division or
its agents before plugging was commenced? yes

Name of Conservation Agent who supervised plugging of this well Wm. T. Owen
Producing formation Depth to top Bottom Total Depth of Well 4680
Show depth and thickness of all water, oil and gas formations.

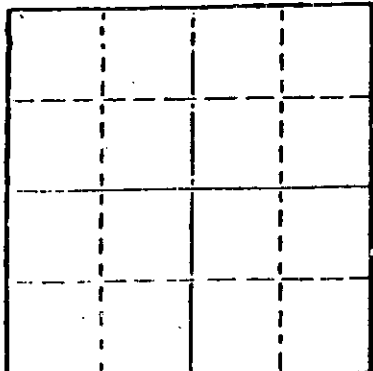

Locate well correctly on above
Section Plot

OIL, GAS OR WATER RECORDS

CASING RECORD

FORMATION	CONTENT	FROM	TO	SIZE	PUT IN	PULLED OUT

Describe in detail the manner in which the well was plugged, indicating where the mud fluid was placed and the method or methods used in introducing it into the hold. If cement or other plugs were used, state the character of same and depth placed, from feet to feet for each plug set.

First plug set at 300' with 40 sacks
Second plug set at 40' with 12 sacks
Three sacks in rat hole

RECEIVED
STATE CORPORATION COMMISSION

APR 30 1979

CONSERVATION DIVISION
Wichita, Kansas

(If additional description is necessary, use BACK of this sheet)

Name of Plugging Contractor Union Drilling Co., Inc.

STATE OF KANSAS COUNTY OF SEDGWICK, ss.
R. D. Messinger (employee of owner) or (owner or operator)
of the above-described well, being first duly sworn on oath, says: That I have knowledge of the facts, statements, and matters herein contained and the log of the above-described well as filed and that the same are true and correct. So help me God.

(Signature)

505 Union Center, Wichita, Kansas
(Address)

SUBSCRIBED AND SWORN TO before me this 16th day of April, 19 79

Cynthia L. Romey
Notary Public.

My commission expires 6-2-82

CONTRACTOR'S WELL LOG

OPERATOR: National Oil Company
CONTRACTOR: Union Drilling Co., Inc.
WELL NAME: Grigsby "A" #1
LOCATION: SW ^{SE} SW Section 15-30S-13W
Barber County, Kansas
COMMENCED: March 28, 1979
COMPLETED: April 11, 1979

02	2873	Shale	Set 8-5/8" @316' w/200 sx.
2873	3865	Lime and shale	
3865	4021	Lime	
4021	4680	Lime and shale	
	4680	T. D.	

We certify that the above and foregoing is a true and correct copy of the log on the Grigsby "A" #1, SW SW SW Section 15-30S-13W, Barber County, Kansas.


UNION DRILLING CO., INC.


R. D. Messinger

STATE OF KANSAS)
) SS
COUNTY OF SEDGWICK)

Subscribed and sworn to before me, a Notary Public, in and for the aforesaid County and State as of this 16th day of April, 1979.

My appointment expires:
6-2-82

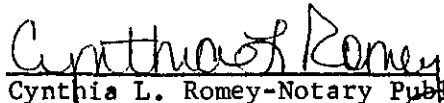
Cynthia L. Romey-Notary Public

RECEIVED
STATE CORPORATION COMMISSION

APR 30 1979

CONSERVATION DIVISION
Wichita, Kansas