

STATE OF KANSAS
STATE CORPORATION COMMISSION


Form CP-4

WELL PLUGGING RECORD

Give All Information Completely
Make Required Affidavit
Mail or Deliver Report to:
Conservation Division
State Corporation Commission
P. O. Box 17027
Wichita, Kansas 67217

Barber County, Sec. 21 Twp. 30 Rge. 13 (S) (W)

Location as "NE/CNW/SW" or footage from lines SE NW SW
Lease Owner Texas Energies, Inc.
Lease Name Lemon #1B Well No.
Office Address Amarillo, Texas 79109
Character of Well (completed as Oil, Gas or Dry Hole)
Date well completed 19
Application for plugging filed 19
Application for plugging approved 19
Plugging commenced 2/21/74 19
Plugging completed 3/1/74 19
Reason for abandonment of well or producing formation depleted

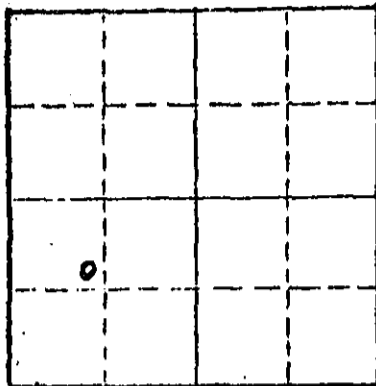

Locate well correctly on above
Section Plat

If a producing well is abandoned, date of last production 19
Was permission obtained from the Conservation Division or its agents before plugging was com-
menced? yes

Name of Conservation Agent who supervised plugging of this well Riberstein
Producing formation Depth to top Bottom Total Depth of Well 4701 Feet
Show depth and thickness of all water, oil and gas formations.

OIL, GAS OR WATER RECORDS

CASING RECORD

FORMATION	CONTENT	FROM	TO	SIZE	PUT IN	PULLED OUT
				8-5/8	723	none
				5 1/2"	4680	3110'

Describe in detail the manner in which the well was plugged, indicating where the mud fluid was placed and the method or methods used in introducing it into the hole. If cement or other plugs were used, state the character of same and depth placed, from feet to feet for each plug set.

Checked hole to 4701', ran sand and loaded hole. Checked sand to 4500', ran sand to 4450' and ran 5 sacks cement. Loaded hole with water, shot pipe at 3694', had trouble getting shot off at 3391', ran dud at 3200', ran another shot at 3200', tried shot at 2982', didn't go off. Worked pipe loose and pulled 100 joints. Set 10' rock bridge at 450' and ran 7 yards ready mix.

PLUGGING COMPLETE.

RECEIVED
STATE CORPORATION COMMISSION
APR 18 1974
CONSERVATION DIVISION
Wichita, Kansas

(If additional description is necessary, use BACK of this sheet)
Name of Plugging Contractor KNIGHT CASING PULLING CO., INC.
Address CHASE, KANSAS

STATE OF KANSAS COUNTY OF RICE ss.
NOEL J. KNIGHT (employee of owner) or (owner or operator) of the above-described well, being first duly sworn on oath, says: That I have knowledge of the facts, statements, and matters herein contained and the log of the above-described well as filed and that the same are true and correct. So help me God.

(Signature) Noel Knight
CHASE, KANSAS (Address)

SUBSCRIBED AND SWORN to before me this 5th day of March 1974

My commission expires
MARGARET MELCHER
NOTARY PUBLIC
Rice County, Kansas
My Commission Expires
Feb. 15, 1975

Margaret Melcher
Notary Public.