


STATE OF KANSAS  
STATE CORPORATION COMMISSION

Form CP-4

WELL PLUGGING RECORD

Give All Information Completely  
Make Required Affidavit  
Mail or Deliver Report to:  
Conservation Division  
State Corporation Commission  
P. O. Box 17027  
Wichita, Kansas 67217  
NORTH

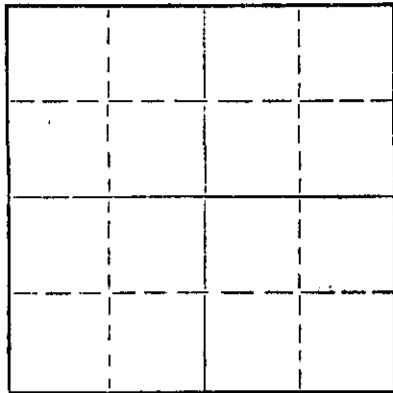

Locate well correctly on above  
Section Plat

Barber County, Sec. 17 Twp. 30S Rge. E3W(E) (W) X  
Location as "NE/CNWxSWx" or footage from lines SW SE  
Lease Owner Glen N. Rupe  
Lease Name Lemon Well No. 1  
Office Address 925 Olive Garvey Bldg., Wichita, Kansas  
Character of Well (completed as Oil, Gas or Dry Hole) D&A  
Date well completed September 25 19 72  
Application for plugging filed September 25 19 72  
Application for plugging approved September 25 19 72  
Plugging commenced September 25 19 72  
Plugging completed September 25 19 72  
Reason for abandonment of well or producing formation D&A

If a producing well is abandoned, date of last production 19  
Was permission obtained from the Conservation Division or its agents before plugging was commenced? Yes

Name of Conservation Agent who supervised plugging of this well G. R. Biberstein  
Producing formation Depth to top Bottom Total Depth of Well 1123 Feet  
Show depth and thickness of all water, oil and gas formations.

OIL, GAS OR WATER RECORDS

CASING RECORD

| FORMATION | CONTENT | FROM | TO | SIZE   | PUT IN | PULLED OUT |
|-----------|---------|------|----|--------|--------|------------|
|           |         |      |    | 8-5/8" | 258'   | -0-        |
|           |         |      |    |        |        |            |
|           |         |      |    |        |        |            |
Describe in detail the manner in which the well was plugged, indicating where the mud fluid was placed and the method or methods used in introducing it into the hole. If cement or other plugs were used, state the character of same and depth placed, from feet to feet for each plug set.


Plugged hole 1123' to 950'. Set plug @ 250',  
cemented with 85 sx from 250 to bottom of cellar.

RECEIVED  
STATE CORPORATION COMMISSION  
NOV 3 1972  
CONSERVATION DIVISION  
Wichita, Kansas

(If additional description is necessary, use BACK of this sheet)  
Name of Plugging Contractor Red Tiger Drilling Company  
Address 1720 Wichita Plaza, Wichita, Kansas 67202

STATE OF Kansas, COUNTY OF Sedgwick, ss.  
Virginia K. Albert (employee of owner) or (owner or operator) of the above-described well, being first duly sworn on oath, says: That I have knowledge of the facts, statements, and matters herein contained and the log of the above-described well as filed and that the same are true and correct. So help me God.

(Signature) Virginia K. Albert  
1720 Wichita Plaza, Wichita, Kansas  
(Address)

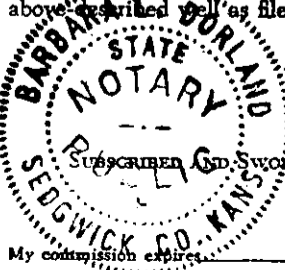

Subscribed and sworn to before me this 30th day of October, 19 72

My commission expires July 25, 1976.

Notary Public.

DRILLERS LOG

No. 1 Lemon

|                                   |             |                        |   |
|-----------------------------------|-------------|------------------------|---|
| CASING RECORD:                    | COMPANY:    | Glen N. Rupe           | DESCRIPTION:                                    |
| 8-5/8" @ 258'<br>w/225 .sx cement | CONTRACTOR: | Red Tiger Drilling Co. | SW SE<br>17-30S-13W<br>Barber County,<br>Kansas |
| TOTAL DEPTH: 1123'                | COMMENCED:  | September 22, 1972     | ELEVATION:                                      |
|                                   | COMPLETED:  | September 25, 1972     |   |

---

| <u>FORMATION</u> | <u>FROM</u> | <u>TO</u> | <u>REMARKS</u> |
|------------------|-------------|-----------|----------------|
| Sand             | 0           | 100       |                |
| Red Shale        | 100         | 260       |                |
| Shale & Sand     | 260         | 772       |                |
| Shale Red        | 772         | 1123      |                |

---

I certify that this is a true and correct copy of the above log to the best of my knowledge.

RED TIGER DRILLING COMPANY

Virginia K. Albert  
Virginia K. Albert

Subscribed and sworn to before me this 30th day of October, 1972.

Barbara L. Dorland  
Notary Public

My Commission Expires:  
July 25, 1976

