

STATE OF KANSAS
STATE CORPORATION COMMISSION


Form CP-4

Give All Information Completely
Make Required Affidavit
Mail or Deliver Report to:
Conservation Division
State Corporation Commission
212 No. Market
Wichita, Kansas 67202

WELL PLUGGING RECORD

C NE NW County. Sec17 Twp30 S Rge.13W (~~XX~~) (W)
Location as "NE/CNWxSWx" or footage from lines 330
Lease Owner National Oil Co.
Lease Name Lemon Well No. 1
Office Address 200 W. Douglas-Suite 550, Wichita, Ks.
Character of Well (completed as Oil, Gas or Dry Hole) D&A
Date well completed January 10, 1972 19
Application for plugging filed January 10, 1972 19
Application for plugging approved January 10, 1972 19
Plugging commenced January 10, 1972 19
Plugging completed January 10, 1972 19
Reason for abandonment of well or producing formation no commercial shows of oil or gas encountered
If a producing well is abandoned, date of last production _____ 19
Was permission obtained from the Conservation Division or its agents before plugging was commenced? yes

NORTH

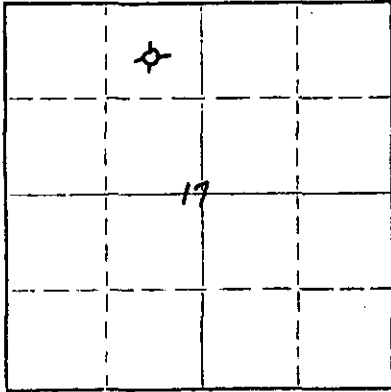

Locate well correctly on above Section Plat

Name of Conservation Agent who supervised plugging of this well _____
Producing formation _____ Depth to top _____ Bottom _____ Total Depth of Well _____ Feet
Show depth and thickness of all water, oil and gas formations.

OIL, GAS OR WATER RECORDS

CASING RECORD

FORMATION	CONTENT	FROM	TO	SIZE	PUT IN	PULLED OUT
surface hole		surf	309	8 5/8"	310	none

Describe in detail the manner in which the well was plugged, indicating where the mud fluid was placed and the method or methods used in introducing it into the hole. If cement or other plugs were used, state the character of same and depth placed, from _____ feet to _____ feet for each plug set.

Plug @300' w/30 sx
Plug @ 40' 2/13 sx
2 sx in rathole

RECEIVED
STATE CORPORATION COMMISSION
FEB 18 1972
CONSERVATION DIVISION
Wichita, Kansas

(If additional description is necessary, use BACK of this sheet)

Name of Plugging Contractor Thomas Drilling Company
Address Duncan, Oklahoma

STATE OF Kansas, COUNTY OF Sedgwick, ss.
Larry L. Taylor (employee of owner) or (owner or operator) of the above-described well, being first duly sworn on oath, says: That I have knowledge of the facts, statements, and matters herein contained and the log of the above-described well as filed and that the same are true and correct. So help me God.

(Signature) Larry L. Taylor
200 W. Douglas-Suite 550, Wichita, Ks.
(Address)

Subscribed and sworn to before me this 17th day of February, 1972

Jean Stocks
Notary Public.

10/25/72



Please Hold Tight

No. 1 Lemon

CASING RECORD:

8-5/8" @ 309'
w/300 sx cement

Total Depth: 4780'

COMPANY: The National Oil Co.

CONTRACTOR: Thomas Drilling Co.

COMMENCED: December 29, 1971

COMPLETED: January 11, 1972

DESCRIPTION:

NE NW
17-30S-13W
Barber County, Kansas

FORMATION

FROM

TO

REMARKS

Sand, Red Rock	0	300	
Red Bed	300	905	
Shale, Shells	905	1490	
Shale	1490	1930	
Lime	1930	2335	
Lime, Shale	2335	2975	
Lime	2975	3325	
Lime, shale	3325	3548	
Lime	3548	3714	
Lime, Shale	3714	3915	
Lime	3915	4780	

RECEIVED
STATE CORPORATION COMMISSION
APR 4 - 1972
CONSERVATION DIVISION
Wichita, Kansas

I certify that this is a true and correct copy of the above log to the best of my knowledge.

THOMAS DRILLING COMPANY

T. H. McCasland, Jr.
T. H. McCasland, Jr.
President

Subscribed and sworn to before me this 21st day of February, 1972.

Josephine Bentley
Notary Public

My Commission Expires:

3-24-75

REC'D FEB 23 1972

No. 1 Lemon

CASING RECORD:

8-5/8" @ 309'
w/300 sk. cement

Total Depth: 4780'

COMPANY: The National Oil Co.

CONTRACTOR: Thomas Drilling Co.

COMMENCED: December 29, 1971

COMPLETED: January 11, 1972

DESCRIPTION:


NE 1/4
17-305-13W
Barber County, Kansas

<u>FORMATION</u>	<u>FROM</u>	<u>TO</u>	<u>REMARKS</u>
Sand, Red Rock	0	300	
Red Bed	300	905	
Shale, Shells	905	1490	
Shale	1490	1980	
Lime	1980	2335	
Lime, Shale	2335	2975	
Lime	2975	3325	
Lime, shale	3325	3548	
Lime	3548	3714	
Lime, Shale	3714	3915	
Lime	3915	4780	


RECEIVED
STATE CORPORATION COMMISSION
MAR 7 1972
CONSERVATION DIVISION
Wichita, Kansas

I certify that this is a true and correct copy of the above log to the best of my knowledge.

THOMAS DRILLING COMPANY

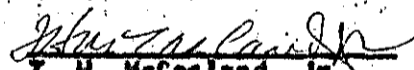
T. H. McCasland, Jr.
President

Subscribed and sworn to before me this 21st day of February, 1972.


Josephine Bentley
Notary Public

My Commission Expires:

3-24-75

REC'D FEB 23 1972