

WELL PLUGGING RECORD

Give All Information Completely
Make Required Affidavit
Mail or Deliver Report to:
Conservation Division
State Corporation Commission
212 No. Market
Wichita, Kansas

Barber County, Sec. 3 Twp. 33S Rge. 13 (E) (W) X

Location as "NE/CNWxSWx" or footage from lines C NW/4 SE/4

Lease Owner Bowers Drilling Company, Inc.

Lease Name Magnuson Well No. 1

Office Address Suite 1434, 125 North Market

Character of Well (completed as Oil, Gas or Dry Hole) Dry Hole

Date well completed 10-28-70 19 70

Application for plugging filed November 4 19 70

Application for plugging approved October 30 19 70


Plugging commenced October 28 19 70

Plugging completed October 28 19 70

Reason for abandonment of well or producing formation Dry Hole

If a producing well is abandoned, date of last production 19

Was permission obtained from the Conservation Division or its agents before plugging was commenced? yes, by telephone

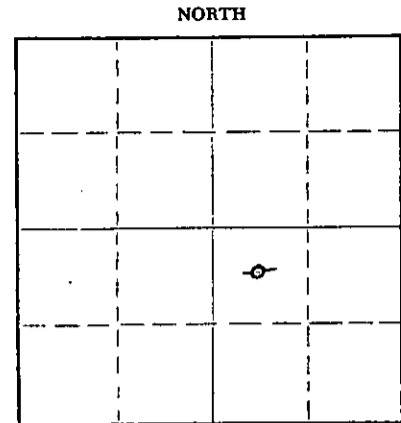

Locate well correctly on above Section Plat

Name of Conservation Agent who supervised plugging of this well Russell Biberstein, Attica, Kansas 67009

Producing formation Depth to top Bottom Total Depth of Well 4570 Feet

Show depth and thickness of all water, oil and gas formations.

OIL, GAS OR WATER RECORDS

CASING RECORD

Table with columns: FORMATION, CONTENT, SIZE, PUT IN, PULLED OUT. Includes a stamp: RECEIVED FROM STATE CORPORATION COMMISSION NOV 5 1970 CONSERVATION DIVISION WICHITA, KANSAS

Describe in detail the manner in which the well was plugged, indicating where the mud fluid was placed and the method or methods used in introducing it into the hole. If cement or other plugs were used, state the character of same and depth placed, from feet to feet for each plug set.

Filled w/heavy mud 4570' to 275'; Plug w/35 Sax Cem. @ 275'; Mud to 40'; set plug w/15 Sax cement @ 40'; Mud to surface.

(If additional description is necessary, use BACK of this sheet)


Name of Plugging Contractor Bowers Drilling Company, Inc.
Address Suite 1434, 125 North Market, Wichita, Kansas

STATE OF KANSAS, COUNTY OF SEDGWICK, ss.
Emil E. Bowers (employee of owner) or (owner or operator) of the above-described well, being first duly sworn on oath, says: That I have knowledge of the facts, statements, and matters herein contained and the log of the above-described well as filed and that the same are true and correct. So help me God.

(Signature) Emil E. Bowers, President
Suite 1434, 125 North Market, Wichita, Kansas
(Address)

SUBSCRIBED AND SWORN to before me this 4th day of November, 1970

My commission expires May 12, 1973

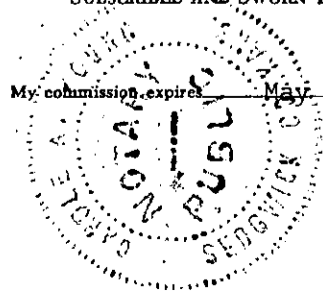

Notary Public signature

WELL LOG

COMPANY: BOWERS DRILLING COMPANY, INC.
 CONTRACTOR: BOWERS DRILLING COMPANY, INC.
 FARM: Magnuson A #1
 LOCATION: C NW SE
 Sec. 3-33S-13W
 Barber County, Kansas
 COMMENCED: 10-24-70
 COMPLETED: 10-28-70
 ELEVATION: 1690 Kelly Bushing
 1689 Derrick Floor
 1685 Ground Level

0 - 3909 Washing Down
 3909 - 4300 Lime & Shale
 4300 - 4570 Lime
 4570 T.D.

RECEIVED
 STATE CORPORATION COMMISSION
 NOV 5 - 78
 CONSERVATION DIVISION
 Wichita, Kansas

LOG TOPS: Elgin Zone 3610 (-1920)
 Elgin Sand 3659 (-1969)
 Heebner 3787 (-2097)
 Douglas Shale 3800 (-2110)
 Douglas Sand 3850 (-2160)
 Lansing 3987 (-2297)
 Mississippian 4497 (-2807)
 Log T.D. 4567

STATE OF KANSAS)
) SS
 COUNTY OF SEDGWICK)

I, Emil E. Bowers, do hereby certify that the above and foregoing is a true and correct copy of the log of the #1 Magnuson A located C NW SE Section 3-33S-13W, Barber County, Kansas, as reflected by the files of Bowers Drilling Company, Inc.

Emil E. Bowers
 Emil E. Bowers

Subscribed and sworn to before me, as Notary Public, in and for the State of Kansas, this 2nd. day of November, 1969.

Carole A. Young
 Carole A. Young, Notary Public

My commission expires May 12, 1973.

