


15-007-19039-0000

STATE OF KANSAS
STATE CORPORATION COMMISSION

WELL PLUGGING RECORD

Give All Information Completely
Make Required Affidavit
Mail or Deliver Report to:
Conservation Division
State Corporation Commission
800 Bitting Building
Wichita, Kansas

Barber County. Sec. 3 Twp. 33 Rge. (E) 13 (W)
Location as "NE/CNWSWK" or footage from lines G. NW SE
Lease Owner William Graham Oil Company
Lease Name H. U. Magnuson Well No. 1
Office Address 1005 East Second Street Wichita, Kansas
Character of Well (completed as Oil, Gas or Dry Hole) Dry Hole
Date well completed August 17, 1954 19
Application for plugging filed August 17, 1954 (Verbal) 19
Application for plugging approved August 17, 1954 (Verbal) 19
Plugging commenced August 17, 1954 19
Plugging completed August 17, 1954 19
Reason for abandonment of well or producing formation Dry Hole

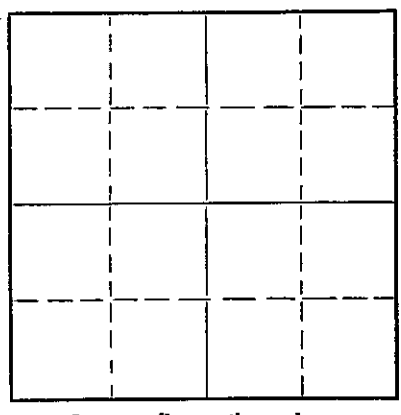

Locate well correctly on above
Section Plat

If a producing well is abandoned, date of last production ----- 19
Was permission obtained from the Conservation Division or its agents before plugging was commenced? Yes

Name of Conservation Agent who supervised plugging of this well M. A. Rives Pratt, Kansas
Producing formation _____ Depth to top _____ Bottom _____ Total Depth of Well 3909 Feet
Show depth and thickness of all water, oil and gas formations.

OIL, GAS OR WATER RECORDS

CASING RECORD

FORMATION	CONTENT	FROM	TO	SIZE	PUT IN	PULLED OUT
				8 5/8"	280'	None

Describe in detail the manner in which the well was plugged, indicating where the mud fluid was placed and the method or methods used in introducing it into the hole. If cement or other plugs were used, state the character of same and depth placed, from _____ feet to _____ feet for each plug set.

Set bottom plug at 275' with
20 sacks cement and 1/2 sack
of hulls. Top plug set at
35' with 10 sacks of cement,
and 1/2 sack hulls. Mud to
surface.

(If additional description is necessary, use BACK of this sheet)

Name of Plugging Contractor Graham-Messman-Rinehart Drilling Company
Address 1005 E. Second Street Wichita, Kansas

STATE OF KANSAS, COUNTY OF SEDGWICK, ss.
William L. Graham (~~employee of owner~~) or (owner or operator) of the above-described well, being first duly sworn on oath, says: That I have knowledge of the facts, statements, and matters herein contained and the log of the above-described well as filed and that the same are true and correct. So help me God.

(Signature) [Signature]
1005 East Second Street, Wichita, Kansas
(Address)

SUBSCRIBED AND SWORN TO before me this 26th day of August, 19 54

[Signature]
Notary Public.

My commission expires June 23, 1958

PLUGGING
FILE SEC 3 T 33 R 13W
BOOK PAGE 57 LINE 25

24-7366-S 3-53-20M
8-28-54
RECORDED
INDEXED

NO. 1 H. U. WASHINGTON

WELL RECORD

Location: O. NW 33 3-330-13W
Barber County, Kansas
Operator: William Graham Gil Company
1005 E. 2nd St., Wichita, Kansas
Contractor: Graham-Hessman-Rinehart Drilling Co.
1005 E. 2nd St., Wichita, Kansas
Commenced: August 6, 1954
Completed: August 17, 1954
Elevation: 1687 K.D.
Productions: M & A
Casing Record: 8 5/8" @ 280' 4/175 sacks cement

LOG

Red bed and shells	280	
Red bed and shells	1170	
Shale and shells	1715	
Shale and shells	1765	
lime and shale	3600	
Sand and shale	3690	
Sand and shale	3725	
lime and shale	3770	
lime and shale	3823	
Shale and sand	3870	
Shale and sand	3875	
Sand and shale	3890	
Sand	3894	
Sand and shale	3909	R.T.D.

TOPS

Elgin sand 3651' (-1964)
Base Elgin sand 3728' (-2041)
Douglas 3821' (-2134)
Douglas sand 3833' (-2151)

The undersigned, GRAHAM-HESSEMAN-RINEHART DRILLING COMPANY, hereby certifies that the above log is a true and correct log of the formation encountered in drilling the above well as reflected by the Daily Drilling Report.

GRAHAM-HESSEMAN-RINEHART DRILLING COMPANY

By: Roger L. Neuman
Roger L. Neuman

Subscribed and sworn to before me this 26th day of August, 1954.

Betty Jane Bayless
Notary Public

My Commission Expires: September 14, 1957.

FILED
AUG 28 1954
8-28-54
DIVISION
Wichita, Kansas

PLUGGING
WELL NO. 3-330-13W
DATE FILED 8/25