


STATE OF KANSAS
STATE CORPORATION COMMISSION

WELL PLUGGING RECORD

Give All Information Completely
Make Required Affidavit
Mail or Deliver Report to
Conservation Division
State Corporation Comm.
245 North Water
Wichita, KS 67202

Barber County. Sec. 28 Twp. 33S Rge. 13 E/W
Location as "NE/CNW $\frac{1}{4}$ SW $\frac{1}{4}$ " or footage from lines C/SE

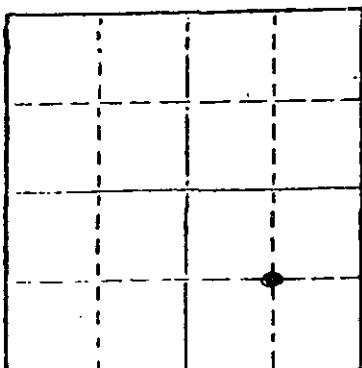

Locate well correctly on above
Section Plat

Lease Owner Gulf Oil Corporation
Lease Name Holmes "B" Well No. 1
Office Address P.O. Box 12116, OKC, OK 73157
Character of Well (Completed as Oil, Gas or Dry Hole)

Gas
Date Well completed 11-9-1981
Application for plugging filed 7-24-1981
Application for plugging approved 11-19-1981
Plugging commenced 10-28-1981
Plugging completed 12-2-1981

Reason for abandonment of well or producing formation
Uneconomical to produce
If a producing well is abandoned, date of last production
Not producing 19
Was permission obtained from the Conservation Division or
its agents before plugging was commenced? Yes

Name of Conservation Agent who supervised plugging of this well Maurice Leslie
Producing formation Miss Chat Depth to top 4604 Bottom 4635 Total Depth of Well 5069
Show depth and thickness of all water, oil and gas formations.

OIL, GAS OR WATER RECORDS

CASING RECORD

FORMATION	CONTENT	FROM	TO	SIZE	PUT IN	PULLED OUT
Mississippi Chat	Gas	4604	4635	13"	280'	None
				8 5/8"	4565'	None

Describe in detail the manner in which the well was plugged, indicating where the mud fluid was placed and the method or methods used in introducing it into the hold. If cement or other plugs were used, state the character of same and depth placed, from feet to feet for each plug set. MIRU PU. RIH w/tbg to 4500' spot 25 sxs 50:50 pozmix, POH to 4378', spot 115 sxs gel to 2500'. POH w/tbg. MIRU Kelso Csg Pullers. Shoot 8-5/8" csg @ 1520' & pull pipe free. POH to 1100', spot 25 sxs 50:50 pozmix w/16% gel, displace w/65 bbls mud. POH to 295' fill hole w/225 sxs 50:50 pozmix w/16% gel. POH w/8-5/8" csg, Rec 51 jts & 2 pup jts 8-5/8" 32# csg 1545'. RDMO. Dig out cellar. Cut off surface pipe and weld cap on well. P&A 12-2-81.

RECEIVED
STATE CORPORATION COMMISSION

(If additional description is necessary, use BACK of this form)
Name of Plugging Contractor Kelso Casing Pullers
MAR 10 1982
3-10-82
CONSERVATION DIVISION
Wichita, Kansas

STATE OF Oklahoma COUNTY OF Oklahoma, ss.
Opal Miller (employee of owner) or (owner or operator)
of the above-described well, being first duly sworn on oath, says: That I have knowledge of the facts, statements, and matters herein contained and the log of the above-described well as filed and that the same are true and correct. So help me God.

(Signature) Opal Miller
P.O. Box 12116, OKC, OK 73157
(Address)

SUBSCRIBED AND SWORN TO before me this 9th day of March, 1982

Patricia A. Wonderly
Notary Public.

My commission expires 01-31-83