


STATE OF KANSAS
STATE CORPORATION COMMISSION

Form CP-4

Give All Information Completely
Make Required Affidavit
Mail or Deliver Report to:
Conservation Division
State Corporation Commission
212 No. Market
Wichita, Kansas 67202
NORTH

WELL PLUGGING RECORD

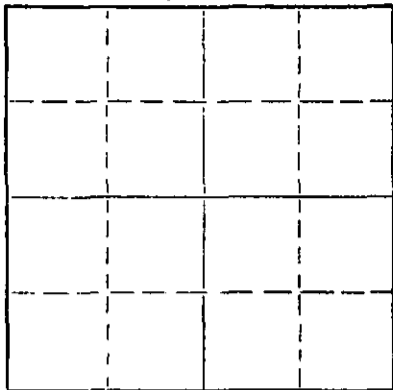

Locate well correctly on above
Section Plat

Barber County. Sec. 28 Twp. 33 Rge. 13 (E) (W) X
Location as "NE/CNW&SW&" or footage from lines SW NW NW
Lease Owner American Petrofina Co. of Texas
Lease Name McKaig B Well No. #1
Office Address Box 209, Russell, Kansas
Character of Well (completed as Oil, Gas or Dry Hole)
Date well completed 19
Application for plugging filed 19
Application for plugging approved 19
Plugging commenced 4-17-70 19
Plugging completed 4-21-70 19
Reason for abandonment of well or producing formation

If a producing well is abandoned, date of last production 19
Was permission obtained from the Conservation Division or its agents before plugging was commenced?

Name of Conservation Agent who supervised plugging of this well G. R. Biberstein
Producing formation Depth to top Bottom Total Depth of Well 4667' Feet
Show depth and thickness of all water, oil and gas formations.

OIL, GAS OR WATER RECORDS

CASING RECORD

FORMATION	CONTENT	FROM	TO	SIZE	PUT IN	PULLED OUT
				5 1/2"	4663'	3723.14'
				8 5/8"	247'	
RECEIVED STATE CORPORATION COMMISSION APR 24 1970 CONSERVATION DIVISION Wichita, Kansas						

Describe in detail the manner in which the well was plugged, indicating where the mud fluid was placed and the method or methods used in introducing it into the hole. If cement or other plugs were used, state the character of same and depth placed, from feet to feet for each plug set.

Made bottom hole plug back with sand from 4640' to 3900'. Mixed and ran 5 sacks cement thru dump bailer from 3900' to 3860'.
Mudded hole from 3860' to 240'. Set 10' rock bridge from 240' to 230'. Filed hole with 3 yards ready mix from 203' to base of cellar.


(If additional description is necessary, use BACK of this sheet)

Name of Plugging Contractor Southwest Casing Pulling Co.
Address Box 364 Great Bend, Kansas

STATE OF Kansas, COUNTY OF Barton, ss.
Southwest Casing Pulling Co. (employee of owner) or (owner or operator) of the above-described well, being first duly sworn on oath, says: That I have knowledge of the facts, statements, and matters herein contained and the log of the above-described well as filed and that the same are true and correct. So help me God.

(Signature) W. C. Spencer Sec.
Box 364, Great Bend, Kansas
(Address)

SUBSCRIBED AND SWORN TO before me this 23 day of April, 1970

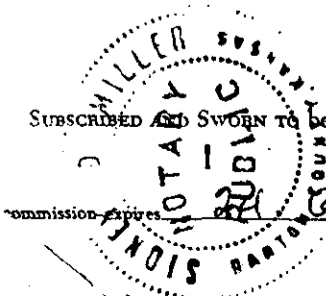

Sidney Miller
Notary Public.

DRILLER'S LOG

McKaig No. 1-B

Lot: SW NW NW

Sec: 28-33-13

Barber County, Kansas

Company: Honaker-Davis Drig. Co., et al

Contractor: Honaker-Davis Drig. Co.

Comm: 1-27-57

Comp: 2-11-57

Rotary Total Depth: 4667'

Casing: 8-5/8" at 247'

5-1/2" at 4663'

0	95	Sand
95	140	Red Bed & Sand
140	200	Shale
200	247	Shale & Shells
247	770	Red Bed, Shale & Shells
770	1070	Red Bed & Shale
1070	1330	Shale & Shells
1330	1350	Shells & Cyp
1350	1590	Shale & Shells
1590	1710	Shells, Cyp & Shale
1710	2020	Shale, Lime & Shells
2020	2170	Shale & Lime
2170	2381	Lime & Shale
2381	2590	Shale & Lime
2590	2715	Shale
2715	2850	Lime & Shale
2850	2950	Shale
2950	4065	Shale & Lime
4065	4667	Lime
4667		Total Rotary Depth

8-5/8" casing cemented at 247' with 225 sacks cement and 2% calcium chloride.

5-1/2" casing cemented at 4663' with 100 sacks cement.

Top of Cement 3870'

RECEIVED
STATE CORPORATION COMMISSION
MAY 12 1970
CONSERVATION DIVISION
Wichita, Kansas

Explorations - 4620-4652, -4582-4604, -4525-40, -4527-22, -4437-47, -4205-15, 3938-42, 3914-24, -3904-10.

I certify that this is the true and correct copy of the above log to the best of my knowledge.

H. S. Forbes
H. S. Forbes

Subscribed and sworn to before me this 15th day of February, 1957.

Kenneth G. Fischer
Kenneth G. Fischer, Notary Public

My commission expires: 6-25-59