


WELL PLUGGING RECORD

Give All Information Completely  
Make Required Affidavit  
Mail or Deliver Report to:  
Conservation Division  
State Corporation Commission  
P. O. Box 17027  
Wichita, Kansas 67217  
NORTH

Barber County, Sec. 9 Twp. 33 Rge. 14 (E) (W)

Location as "NE/CNW/SW" or footage from lines C NW NW  
Lease Owner Texas Energies, Inc.  
Lease Name Allen #1 Well No. \_\_\_\_\_  
Office Address Amarillo, Texas  
Character of Well (completed as Oil, Gas or Dry Hole) \_\_\_\_\_  
Date well completed \_\_\_\_\_ 19\_\_\_\_  
Application for plugging filed \_\_\_\_\_ 19\_\_\_\_  
Application for plugging approved \_\_\_\_\_ 19\_\_\_\_  
Plugging commenced 2/11/74 \_\_\_\_\_ 19\_\_\_\_  
Plugging completed 2/20/74 \_\_\_\_\_ 19\_\_\_\_  
Reason for abandonment of well or producing formation depleted.

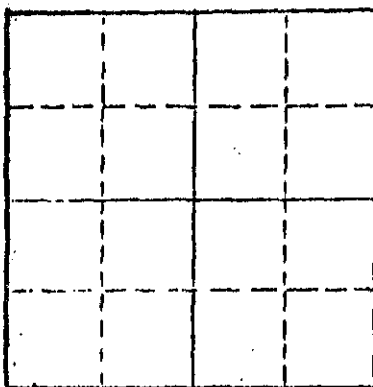

Locate well correctly on above Section Plot

If a producing well is abandoned, date of last production \_\_\_\_\_ 19\_\_\_\_  
Was permission obtained from the Conservation Division or its agents before plugging was commenced? yes

Name of Conservation Agent who supervised plugging of this well Biberstein  
Producing formation \_\_\_\_\_ Depth to top \_\_\_\_\_ Bottom \_\_\_\_\_ Total Depth of Well 4700 Feet  
Show depth and thickness of all water, oil and gas formations.

OIL, GAS OR WATER RECORDS

CASING RECORD

FORMATION	CONTENT	FROM	TO	SIZE	PUT IN	PULLED OUT
				8-5/8	329	none
				5 1/2"	4692	3825'

Describe in detail the manner in which the well was plugged, indicating where the mud fluid was placed and the method or methods used in introducing it into the hole. If cement or other plugs were used, state the character of same and depth placed, from \_\_\_\_\_ feet to \_\_\_\_\_ feet for each plug set.

Checked hole to 4700' and ran sand to 4650', ran 5 sacks of cement. Loaded hole with water, shot pipe at 3980', 3800', pulled 122 joints. Pumped 2 sacks hulls, 20 sacks gel and 125 sacks cement.

PLUGGING COMPLETE.

RECEIVED  
STATE CORPORATION COMMISSION  
APR 18 1974  
21-18-74  
CONSERVATION DIVISION  
Wichita, Kansas

(If additional description is necessary, use BACK of this sheet)  
Name of Plugging Contractor KNIGHT CASING PULLING CO., INC.  
Address CHASE, KANSAS

STATE OF KANSAS COUNTY OF RICE  
NOEL J. KNIGHT (employee of owner) or (owner or operator) of the above-described well, being first duly sworn on oath, says: That I have knowledge of the facts, statements, and matters herein contained and the log of the above-described well as filed and that the same are true and correct. So help me God.

(Signature) Noel Knight  
CHASE, KANSAS (Address)

Subscribed and Sworn to before me this 22nd day of February 19 74

My commission expires \_\_\_\_\_  
MARGARET MELCHER  
NOTARY PUBLIC  
Rice County, Kansas  
My Commission Expires  
Feb. 15, 1975

Margaret Melcher  
Notary Public