


STATE OF KANSAS
STATE CORPORATION COMMISSION

WELL PLUGGING RECORD

Give All Information Completely
Make Required Affidavit
Mail or Deliver Report to
Conservation Division
State Corporation Comm.
245 North Water
Wichita, KS 67202

Barber County. Sec. 5 Twp. 33S Rge. 14W E/W
Location as "NE/CNW $\frac{1}{4}$ SW $\frac{1}{4}$ " or footage from lines
E/2 SW SE

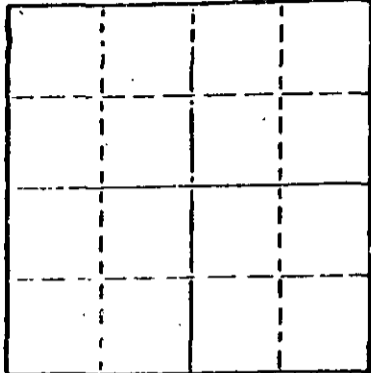

Locate well correctly on above
Section Plot

Lease Owner National Oil Company
Lease Name Cline-Mills Well No. 1
Office Address 200 W. Douglas, Suite 550, Wichita, KS
Character of Well (Completed as Oil, Gas or Dry Hole)
dry hole

Date Well completed February 10 1979
Application for plugging filed February 10 19 79
Application for plugging approved February 10 19 79
Plugging commenced February 10 19 79
Plugging completed February 10 19 79

Reason for abandonment of well or producing formation
dry
If a producing well is abandoned, date of last production
19

Was permission obtained from the Conservation Division or
its agents before plugging was commenced? yes

Name of Conservation Agent who supervised plugging of this well Wm. T. Owen
Producing formation _____ Depth to top _____ Bottom _____ Total Depth of Well 4750
Show depth and thickness of all water, oil and gas formations.

OIL, GAS OR WATER RECORDS

CASING RECORD

FORMATION	CONTENT	FROM	TO	SIZE	PUT IN	PULLED OUT

Describe in detail the manner in which the well was plugged, indicating where the mud fluid
was placed and the method or methods used in introducing it into the hold. If cement or other
plugs were used, state the character of same and depth placed, from _____ feet to
_____ feet for each plug set.

First Plug set at 600' with 40 sacks
Bridge set at 40' with 12 sacks
Three sacks in rat hole

RECEIVED
STATE CORPORATION COMMISSION

MAR - 2 1979
3-2-79
CONSERVATION DIVISION
Wichita, Kansas

(If additional description is necessary, use BACK of this sheet)

Name of Plugging Contractor Union Drilling Co., Inc.

STATE OF KANSAS COUNTY OF SEDGWICK, ss.

R. D. Messinger (employee of owner) or (owner or operator)
of the above-described well, being first duly sworn on oath, says: That I have knowledge of
the facts, statements, and matters herein contained and the log of the above-described well
as filed and that the same are true and correct. So help me God.

(Signature) *R. D. Messinger*
505 Union Center, Wichita, Kansas
(Address)

SUBSCRIBED AND SWORN TO before me this 13th day of February, 1979

My commission expires 6-2-82

Cynthia L. Romey
Cynthia L. Romey Notary Public.

CONTRACTOR'S WELL LOG

OPERATOR:	National Oil Company
CONTRACTOR:	Union Drilling Co., Inc.
LEASE NAME:	Cline-Mills #1
LOCATION:	E/2 SW SE Section 5-33S-14W Barber County, Kansas
COMMENCED:	January 29, 1979
COMPLETED:	February 10, 1979

0	40	Red bed, gyp, and red rock	Set 8-5/8" @ 890 w/ 850 sacks
40	345	Red bed	
345	775	Red bed and shale	
775	909	Red bed, shale, gyp and red rock	
909	919	Red bed and shale	
919	1586	Red rock, shale, gyp and sand	
1586	1978	Shale	
1978	2916	Shale and lime	
2916	3135	Shale	
3135	3952	Shale and lime	
3952	4115	Lime and shale	
4115	4233	Shale and lime	
4233	4640	Lime	
4640	4696	Lime and shale and chert	
4696	4710	Lime and chert	
4710	4735	Lime	
4735	4750	Shale and lime	
4750		T. D.	

We certify that the above and foregoing is a true and correct copy of the log on the Cline-Mills #1, E/2 SW SE Section 5-33S-14W, Barber County, Kansas.

UNION DRILLING CO., INC.

R. D. Messinger
 R. D. Messinger

STATE OF KANSAS)
) SS
 COUNTY OF SEDGWICK)

Subscribed and sworn to before me, a Notary Public, in and for the afore said County and State as of this 13th day of February, 1979

My appointment expires:

6-2-82

RECEIVED
 STATE CORPORATION COMMISSION

MAR - 2 1979
 3-2-79
 CONSERVATION DIVISION
 Wichita, Kansas

Cynthia L. Roney
 Cynthia L. Roney-Notary Public