


STATE OF KANSAS
STATE CORPORATION COMMISSION

WELL PLUGGING RECORD

Give All Information Completely
Make Required Affidavit
Mail or Deliver Report to
Conservation Division
State Corporation Comm.
245 North Water
Wichita, KS 67202

Barber County. Sec. 5 Twp. 33S Rge. 14W ~~XXX~~
Location as "NE/CNW $\frac{1}{4}$ /SW $\frac{1}{4}$ " or footage from lines _____
2310' ESL & 660' FEL
Lease Owner Texas Oil and Gas Corp.
Lease Name Cline-Mills Well No. 1
Office Address 200 W. Douglas-Suite 300 Wichita, KS
Character of Well (Completed as Oil, Gas or Dry Hole) 67202

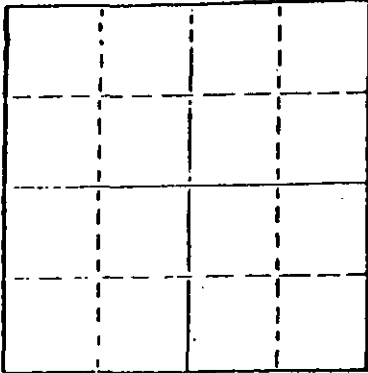

Locate well correctly on above
Section Plat

Dry Hole
Date Well completed November 17, 19 77
Application for plugging filed Verbal Application 19
Application for plugging approved Verbal Approval 19
Plugging commenced November 17, 19 77
Plugging completed November 17, 19 77
Reason for abandonment of well or producing formation _____

If a producing well is abandoned, date of last production 19

Was permission obtained from the Conservation Division or its agents before plugging was commenced? Yes

Name of Conservation Agent who supervised plugging of this well Wm. T. Owen
Producing formation _____ Depth to top _____ Bottom _____ Total Depth of Well 4,750'
Show depth and thickness of all water, oil and gas formations.

OIL, GAS OR WATER RECORDS

CASING RECORD

FORMATION	PERCENT	FROM	TO	SIZE	PUT IN	PULLED OUT
				8 5/8"	394'	None

RECEIVED
STATE CORPORATION COMMISSION
NOV 28 1977
11-28-77
CONSERVATION DIVISION
Wichita, Kansas

Describe in detail the manner in which the well was plugged, indicating where the mud fluid was placed and the method or methods used in introducing it into the hold. If cement or other plugs were used, state the character of same and depth placed, from _____ feet to _____ feet for each plug set.

Filled hole with heavy rotary mud from 4,750 ft. (rotary total depth) to 600 ft. Set plug 600 ft. and cemented with 40 sacks cement. Filled hole with heavy rotary mud from 600 ft. to 40 ft. Set solid plug at 40 ft. and cemented to cellar with 12 sacks cement, 3 sacks cement in rat hole.


Plugging operations accomplished utilizing Haliburton Oil Well cementing pump truck through 4 1/2 inch drill pipe.

(If additional description is necessary, use BACK of this sheet)

Name of Plugging Contractor Haliburton Services
410 Union Center Bldg., Wichita, Kansas 67202

STATE OF Kansas COUNTY OF Sedgwick, ss.
Dean Britting, Agent (employee of owner) or (owner or operator) of the above-described well, being first duly sworn on oath, says: That I have knowledge of the facts, statements, and matters herein contained and the log of the above-described well as filed and that the same are true and correct. So help me God.

(Signature) Dean Britting
200 N. Main, Wichita, Kansas 67202
(Address)

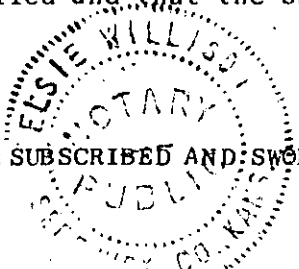

SUBSCRIBED AND SWORN TO before me this 25th day of November, 19 77

Elsie Willison
Elsie Willison - Notary Public.

My commission expires June 30, 1978

KANSAS GEOLOGICAL SOCIETY API# 15-007-20,557-0000
 KANSAS WELL LOG BUREAU - KANSAS WELL SAMPLE BUREAU
 KANSAS GEOLOGICAL SOCIETY BUILDING
 508 EAST MURDOCK - WICHITA, KANSAS


COMPANY Texas Oil and Gas Corp.

SEC. 5 T. 33S. R. 14W
 LOC. 2310'FSL & 660'FEL

FARM Cline-Mills NO. 1

COUNTY Barber

TOTAL DEPTH 4,750'
 COMM. November 7, 1977 COMP. November 17, 1977
 SHOT OR TREATED
 CONTRACTOR H-30, Inc.
 ISSUED November 25, 1977.

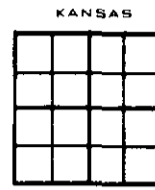

CASING
 20 10
 15 8 -5/8" 394' cemented w/375 sxs cement ELEVATION 1,778'K.B.
 12 6
 13 5

PRODUCTION

FIGURES INDICATE BOTTOM OF FORMATIONS

Red Bed and Shale	425'
Shale	2,112'
Lime and Shale	2,240'
Shale and Lime	2,420'
Chert and Shale	2,640'
Shale and Lime	3,075'
Lime and Shale	4,395'
Shale and Lime	4,510'
Lime	4,625'
Lime and Chert	4,750'
Rotary Total Depth	4,750'

RECEIVED
 STATE CORPORATION COMMISSION
 NOV 29 1977
 11-29-77
 CONSERVATION DIVISION
 Wichita, Kansas

I hereby certify the above and foregoing to be a true and correct log of the above described well as shown by the drilling reports.

H-30, INC.

Dean Britting

 Dean Britting

State of Kansas }
 County of Sedgwick } ss:

Suscribed and Sworn to before me a Notary Public in and for said county and state this 25th day of November, 1977.

Elsie Willison

 Elsie Willison - Notary Public

My Commission Expires:
 June 30, 1978

