


STATE OF KANSAS
STATE CORPORATION COMMISSION

WELL PLUGGING RECORD

Give All Information Completely
Make Required Affidavit
Mail or Deliver Report to:
Conservation Division
State Corporation Commission
211 No. Broadway
Wichita, Kansas

NORTH

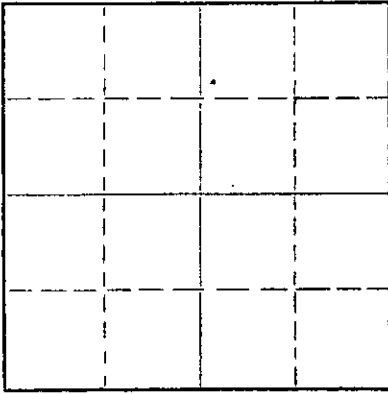

Locate well correctly on above
Section Plat

Barber County, Sec. 3 Twp. 33 Rge. 11 (E) W (W)
Location as "NE/CNW&SW¼" or footage from lines C S $\frac{1}{2}$ NW NE
Lease Owner Mill Drilling Co Inc.
Lease Name Raymond Hull Well No. 2
Office Address 670 N. 11th. Natl. Bank Bldg. Wichita, Kansas
Character of Well (completed as Oil, Gas or Dry Hole) Dry hole.
Date well completed 5-8-62 19
Application for plugging filed 5-8-62 19
Application for plugging approved 5-8-62 19
Plugging commenced 5-8-62 19
Plugging completed 5-8-62 19
Reason for abandonment of well or producing formation Non productive.

If a producing well is abandoned, date of last production 19
Was permission obtained from the Conservation Division or its agents before plugging was commenced? Yes

Name of Conservation Agent who supervised plugging of this well Fred Hampel
Producing formation _____ Depth to top _____ Bottom _____ Total Depth of Well ~~###~~ 1710 Feet
Show depth and thickness of all water, oil and gas formations.

OIL, GAS OR WATER RECORDS

CASING RECORD

FORMATION	CONTENT	FROM	TO	SIZE	PUT IN	PULLED OUT

Describe in detail the manner in which the well was plugged, indicating where the mud fluid was placed and the method or methods used in introducing it into the hole. If cement or other plugs were used, state the character of same and depth placed, from _____ feet to _____ feet for each plug set.

Hole filled with drlg. mud to depth of 258'. A plug was put at this depth with $\frac{1}{2}$ sack hulls added. Twenty sacks cement put on top of plug. A second plug was put at a depth of 140' with $\frac{1}{2}$ sack hulls added on top of plug and 10 sacks cement. This plugged hole. Two sacks cement was put in rat hole plugging same.

RECEIVED
STATE CORPORATION COMMISSION
MAY 22 1962
5-22-62
CONSERVATION DIVISION
Wichita, Kansas

(If additional description is necessary, use BACK of this sheet)

Name of Plugging Contractor Co. tools.
Address Same as above.

STATE OF KANSAS, COUNTY OF SEDGWICK, ss.
Joseph O. Butts (employee of owner) or (owner or operator) of the above-described well, being first duly sworn on oath, says: That I have knowledge of the facts, statements, and matters herein contained and the log of the above-described well as filed and that the same are true and correct. So help me God.

(Signature) Joseph O. Butts
Wichita, Kansas (Address)

SUBSCRIBED AND SWORN TO before me this 21st day of May, 19 62

Bertie H. Salter

My commission expires October 16, 1965

Notary Public.



ROTARY DRILLERS LOG

COMPANY: Mull Drilling Co., Inc. et al ROTARY DRILLING COMMENCED: 4/21/62
 Wichita, Kansas

CONTRACTOR: Mull Drilling Co., Inc. ROTARY DRILLING COMPLETED: 5/8/62
 Wichita, Kansas

CASING RECORD: Set 258' of 8 5/8" csg. LOCATION: HULL #2
 w/250 sq cmt. C NW NE 3-33S-14W
 D & A Barber County, Kansas

(Figures indicate bottom of formation - measurements from top of Rotary Bushing)

1900'	Shale & Shells
2045'	Shale w/Lime
2766'	Lime & Shale
2950'	Sandy Lime & Shale
3283'	Lime & Shale
3595'	Sandy Lime & Shale
4457'	Lime & Shale
4535'	Lime
4596'	Lime & Shale
4653'	Lime
4686'	Lime & Shale - total depth

RECEIVED
 STATE CORPORATION COMMISSION
 MAY 22 1962
 5-22-62
 CONSERVATION DIVISION
 Wichita, Kansas


I hereby certify that this is a true and correct copy of the above log to the best of my knowledge.

MULL DRILLING COMPANY, INC.

Albert J. Costa
 Albert J. Costa, Geologist

STATE OF KANSAS)
) SS
 COUNTY OF SEDGWICK)

Subscribed and sworn to before me this 9th day of May, 1962.

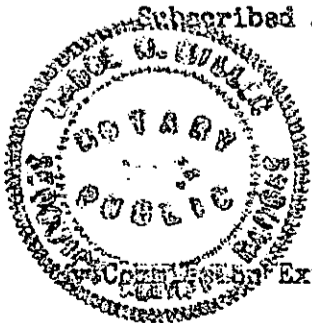

Mada N. Miller
 Notary Public