

15-007-00387-0000


STATE OF KANSAS
STATE CORPORATION COMMISSION

WELL PLUGGING RECORD

Give All Information Completely
Make Required Affidavit
Mail or Deliver Report to:
Conservation Division
State Corporation Commission
211 No. Broadway
Wichita, Kansas

Barber County, Sec. 3 Twp. 33 Rge. 14 (E) W (W)
Location as "NE/CNW/SE/SW" or footage from lines C SW SW
Lease Owner Honaker-Davis Drlg. Co.
Lease Name Allen Well No. 1
Office Address 2008 Lakin, Great Bend, Kansas
Character of Well (completed as Oil, Gas or Dry Hole) Dry Hole
Date well completed 5-26 1957
Application for plugging filed 5-26 1957
Application for plugging approved 5-26 1957
Plugging commenced 1:00 P.M. 5-26 1957
Plugging completed 2:00 P.M. 5-26 1957
Reason for abandonment of well or producing formation _____

NORTH

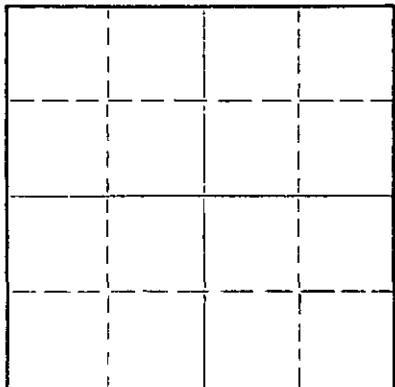

Locate well correctly on above
Section Plat

If a producing well is abandoned, date of last production _____ 19____
Was permission obtained from the Conservation Division or its agents before plugging was commenced? Yes

Name of Conservation Agent who supervised plugging of this well Merrill Rives, Pratt, Kansas
Producing formation _____ Depth to top _____ Bottom _____ Total Depth of Well _____ Feet
Show depth and thickness of all water, oil and gas formations.

OIL, GAS OR WATER RECORDS

CASING RECORD

FORMATION	CONTENT	FROM	TO	SIZE	PUT IN	PULLED OUT
				8-5/8	918	None .

Describe in detail the manner in which the well was plugged, indicating where the mud fluid was placed and the method or methods used in introducing it into the hole. If cement or other plugs were used, state the character of same and depth placed, from _____ feet to _____ feet for each plug set.

Filled hole with heavy rotary mud to 300'. Set plug and dumped in 20 sacks cement through drill pipe.

Filled hole with heavy rotary mud to 35'. Set used plug with 1/3 sack hulls on top. Dumped in 10 sacks cement. Cement filled hole to bottom of cellar.

(If additional description is necessary, use BACK of this sheet)

Name of Plugging Contractor _____
Address _____

STATE OF KANSAS, COUNTY OF BARTON, ss.
Jay Bowen (employee of owner) or (~~owner or operator~~) of the above-described well, being first duly sworn on oath, says: That I have knowledge of the facts, statements, and matters herein contained and the log of the above-described well as filed and that the same are true and correct. So help me God.

(Signature) Jay Bowen
Great Bend, Kansas (Address)

SUBSCRIBED AND SWORN TO before me this 27th day of May 1957
[Signature]
STATE CORPORATION COMMISSION Notary Public.

My commission expires 6-25-59

PLUGGING
FILE SEC 3 T 33 R 14 W
BOOK PAGE 15 LINE 34

MAY 28 1957
5-28-57
CONSERVATION DIVISION
WICHITA, KANSAS

DRILLER'S LOG

Allen No. 1
 Loc: C SW SW
 Sec: 3-33S-14W
 Barber County, Kansas
 Company: Honaker-Davis Drlg. Co., et al
 Contractor: Honaker-Davis Drlg. Co.

Comm: 5- 6-57
 Comp: 5-26-57
 Rotary Total Depth: 5005
 Casing: 8-5/8" at 918'
 D & A.

0	155	Red Bed & Shale	
155	170	Sand	
170	195	Shale & Shells	
195	220	Sand	
220	820	Shale & Shells	8-5/8" casing cemented at
820	1150	Red Bed & Shale	918' with 150 sacks common
1150	1990	Shale & Shells	cement, 2% calcium chloride
1990	2350	Shale, Lime & Shells	and 15% stratacrete.
2350	2440	Lime & Shale	Cemented outside 8-5/8"
2440	2752	Shale & Lime	through 1" pipe at 600'
2752	2825	Shale	with 450 sacks cement,
2825	2970	Shale & Shells	2% calcium chloride and
2970	3070	Shale	15% Stratacrete.
3070	3335	Shale & Lime	Cemented through 1" pipe
3335	3425	Lime & Shale	at 120' with 100 sacks
3425	3870	Shale & Lime	cement, 4% Calcium chloride
3870	4021	Lime & Shale	
4021	4100	Sand & Shale	
4100	4180	Sand & Lime	
4180	4205	Lime & Shale	
4205	5005	Lime	
5005		Total Rotary Depth	D & A

I certify that this is the true and correct copy of the above log to the best of my knowledge.

H. S. Forbes

 H. S. Forbes

Subscribed and sworn to before me this 27th day of May, 1957.

Kenneth G. Fischer

 Kenneth G. Fischer, Notary Public

My commission expires; 6-25-59

RECEIVED
 STATE CORPORATION COMMISSION

MAY 28 1957
 5-28-57
 CONSERVATION DIVISION
 Wichita, Kansas

PLUGGING
 FILE SEC. 3 T. 33 S. 14W
 BOOK PAGE 15 LINE 34