


Give All Information Completely
Make Required Affidavit
Mail or Deliver Report to:
Conservation Division
State Corporation Commission
211 No. Broadway
Wichita, Kansas

WELL PLUGGING RECORD

Barber County. Sec. 30 Twp. 31 Rge. (E) 11W(W)
Location as "NE/CNWxSWx" or footage from lines SE NW SE
Lease Owner Lario Oil & Gas Company
Lease Name Nuckolls Well No. 4
Office Address 301 S. Market, Wichita, Kansas 67202
Character of Well (completed as Oil, Gas or Dry Hole) Oil
Date well completed September 15 19 65
Application for plugging filed September 16 19 65
Application for plugging approved September 17 19 65
Plugging commenced September 25 19 65
Plugging completed September 28 19 65
Reason for abandonment of well or producing formation depleted

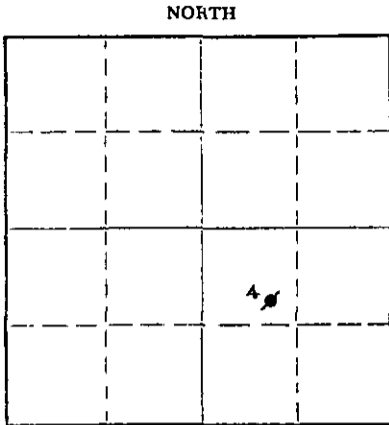

Locate well correctly on above Section Plat

If a producing well is abandoned, date of last production April 11 19 65
Was permission obtained from the Conservation Division or its agents before plugging was commenced? Yes

Name of Conservation Agent who supervised plugging of this well Archie V. Elvis
Producing formation Mississippi Depth to top 4277 Bottom Total Depth of Well 4295 1/2 Feet
Show depth and thickness of all water, oil and gas formations.

OIL, GAS OR WATER RECORDS

CASING RECORD

FORMATION	CONTENT	FROM	TO	SIZE	PUT IN	PULLED OUT
				8 5/8"	149	None
				5 1/2"	4290.66	2510

Describe in detail the manner in which the well was plugged, indicating where the mud fluid was placed and the method or methods used in introducing it into the hole. If cement or other plugs were used, state the character of same and depth placed, from feet to feet for each plug set.

Set plug at 3530', 50' sand to 3480'. 5 sacks cement to 3455'.
10' rock bridge at 200', 25 sacks cement to 125', mud to 40', 5' rock bridge and 10 sacks cement to base of cellar.

RECEIVED
STATE CORPORATION COMMISSION

OCT 4 1965
10-4-65
CONSERVATION DIVISION
Wichita, Kansas

(If additional description is necessary, use BACK of this sheet)
Name of Plugging Contractor Glenn & Smith
Address Ellinwood, Kansas

STATE OF Kansas, COUNTY OF Sedgwick, ss.
Leo Ross (employee of owner) or (owner or operator) of the above-described well, being first duly sworn on oath, says: That I have knowledge of the facts, statements, and matters herein contained and the log of the above-described well as filed and that the same are true and correct. So help me God.

(Signature) [Signature]
301 S. Market, Wichita, Kansas 67202
(Address)

SUBSCRIBED AND SWORN to before me this 1st day of October, 19 65

[Signature]
Notary Public.

My commission expires July 21, 1966



15-007-01332-0000

LARIO OIL & GAS COMPANY

No. 4 Nuckolls

SE NW SE Sec. 30-31S-11W, Barber County, Kansas

Drilling Contractor: Group Exploration Company

Drilling Commenced: 8-30-53

Drilling Completed: 9-15-53

Initial Test: 9-21-53 Flowed thru tubing

6 1/2 BOPH for 7 hours.

Formation:

Depth:

Red bed	130
Shale	165
Shale & red bed	300
Shale	355
Shale & red bed	770
Shale	1140
Shale & shells	1455
Shale & lime	1890
Lime	2405
Shale & lime	2530
Shale & shells	2715
Lime & shale	2900
Lime	2965
Shale	3090
Lime	3240
Shale & lime	3320
Shale	3341
Sand	3430
Shale & lime	3505
Shale	3549
Sand	3615
Sand & shale	3700
Shale	3718
Lime	4285
Lime	4295 1/2

Casing Record:

8 5/8" set at 149' cem. 100 sacks.
 5 1/2" 4290.66' set at 4282' - Cem.
 250 sacks.

GEOLOGICAL TOPS (SAMPLE) D.F. MEAS.

Elgin Sand	3341	(-1609)
Base Oread	3499	(-1967)
Douglas Sand	3543	(-2011)
Lansing K.G.	3712	(-2180)
Mississippi	4277	(-2665)

RECEIVED
 STATE CORPORATION COMMISSION
 SEP 17 1965
 9-17-65
 CONSERVATION DIVISION
 Wichita, Kansas