

15-007-01331-0000

STATE OF KANSAS  
STATE CORPORATION COMMISSION

WELL PLUGGING RECORD


Give All Information Completely  
Make Required Affidavit  
Mail or Deliver Report to:  
Conservation Division  
State Corporation Commission  
211 No. Broadway  
Wichita, Kansas

Barber County, Sec. 30 Twp. 31 Rge. (E) 11W

Location as "NE/CNW/SW" or footage from lines N/2 N/2 SE Sec. 30-31S-11W  
Lease Owner Lario Oil & Gas Company  
Lease Name Nuckolls Well No. 3  
Office Address 301 S. Market, Wichita, Kansas 67202  
Character of Well (completed as Oil, Gas or Dry Hole) Oil Well  
Date well completed May 20 19 52  
Application for plugging filed September 16 19 65  
Application for plugging approved September 17 19 65  
Plugging commenced September 22 19 65  
Plugging completed September 24 19 65  
Reason for abandonment of well or producing formation Depleted

If a producing well is abandoned, date of last production April 4 19 65  
Was permission obtained from the Conservation Division or its agents before plugging was commenced? Yes

Name of Conservation Agent who supervised plugging of this well Archie V. Elving  
Producing formation Mississippi Depth to top 4306' Bottom Total Depth of Well 4325' Feet  
Show depth and thickness of all water, oil and gas formations.

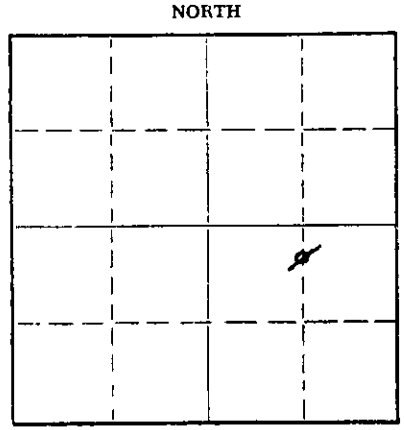

Locate well correctly on above Section Plat

OIL, GAS OR WATER RECORDS

CASING RECORD

| FORMATION | CONTENT | FROM | TO | SIZE   | PUT IN | PULLED OUT |
|-----------|---------|------|----|--------|--------|------------|
|           |         |      |    | 8 5/8" | 139'   | None       |
|           |         |      |    | 5 1/2" | 4312'  | 2680'      |
|           |         |      |    |        |        |            |
|           |         |      |    |        |        |            |
|           |         |      |    |        |        |            |
|           |         |      |    |        |        |            |

Describe in detail the manner in which the well was plugged, indicating where the mud fluid was placed and the method or methods used in introducing it into the hole. If cement or other plugs were used, state the character of same and depth placed, from \_\_\_\_\_ feet to \_\_\_\_\_ feet for each plug set.

Set plug at 3375'-50' sand to 3325 - 5 sacks cement to 3300'.  
Set plug at 215'--15' rock bridge to 200'.  
15 sacks cement to 155'--mud to 145'.  
5' rock bridge to 140'--10 sacks cement to 110'.  
Mud to 40'--10' rock bridge to 30'.  
10 sacks cement to base of cellar.

RECEIVED  
STATE CORPORATION COMMISSION  
SEP 28 1965  
9-28-65  
CONSERVATION DIVISION  
Wichita, Kansas

Name of Plugging Contractor Glenn & Smith Pipe Pulling Co.  
Address Ellinwood, Kansas

STATE OF Kansas, COUNTY OF Sedgwick, ss.  
Leo Ross (employee of owner) or (owner) of the above-described well, being first duly sworn on oath, says: That I have knowledge of the facts, statements, and matters herein contained and the log of the above-described well as filed and that the same are true and correct. So help me God.

(Signature) *Leo Ross*

(Address)

SUBSCRIBED AND SWORN TO before me this 27th day of September, 19 65

*Frances L. Loh*  
Notary Public.

My commission expires July 21, 1966



Lario Oil & Gas Company  
Nuckolls Well # 3  
Comm.  
Comp. Rotary

5/3/52  
5/20/52

Location Cen. N/2 N/2 SE/4  
Section 30-31S-R11W Barber County,  
Kansas.  
CASING RECORD  
8 5/8" Casing at 139 Ft W/ 100 Sacks  
5 1/2" " at 4306 " " 250 "

|                         |      |
|-------------------------|------|
| Celler                  | 10   |
| Red Bed                 | 142  |
| Red Rock                | 160  |
| Red Bed, Shale & Shells | 965  |
| Shale & Shells          | 1250 |
| Salt, Shale & Shells    | 1515 |
| Lime & Shale            | 2240 |
| Shale & Shells          | 2395 |
| Lime & Shale            | 2680 |
| Shale                   | 2790 |
| Lime & Shale            | 3295 |
| Shale & Shells          | 3395 |
| Sand & Shale            | 3412 |
| Sand                    | 3430 |
| Lime & Sandy shale      | 3538 |
| Sand & Shale            | 3718 |
| Lime                    | 3730 |
| Sandy Shale             | 3737 |
| Lime                    | 4005 |
| Lime & Shale            | 4040 |
| Lime                    | 4165 |
| Lime & Shale            | 4306 |
| Chert                   | 4325 |
| Total Depth             | 4325 |

GEOLOGICAL TOPS:

|                  |         |         |
|------------------|---------|---------|
| Elevation        | 1552 DF | 1555 RB |
| Elgin Sand       | 3361    | -1806   |
| Lansing KC Group | 3734    | -2183   |
| Cherokee         | 4292    | -2737   |
| Mississippi Chat | 4306    | -2751   |
| Rotary T.D.      | 4325    | -2770   |

RECEIVED  
STATE CORPORATION COMMISSION

SEP 17 1965  
9-17-65  
CONSERVATION DIVISION  
Wichita, Kansas

State of Kansas COUNTY OF Sedgwick ss,

I, the undersigned, being duly sworn, on oath state that the above statement and log is a true and correct record and log of the well drilled at the location above described.

R. C. PATTON CO.,

By R.C. Patton

Subscribed and sworn to before me this 9th day of June 1952.

J.P. Henderson  
Notary Public.

My Commission expires Oct 4th, 1952.

