


Give All Information Completely
Make Required Affidavit
Mail or Deliver Report to:
Conservation Division
State Corporation Commission
212 No. Market
Wichita, Kansas

WELL PLUGGING RECORD

NORTH

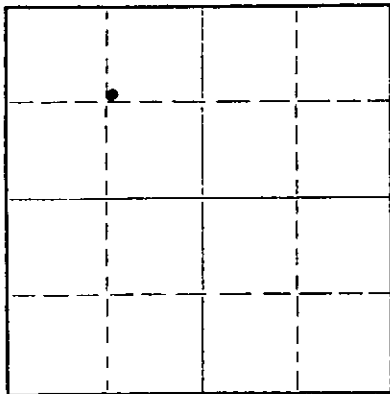

Locate well correctly on above
Section Plat

Barber County, Sec. 27 Twp. 30S Rge. (E) 12 (W)
Location as "NE/CNWxSWx" or footage from lines 1379' FNL & 1454' FWL
Lease Owner Anadarko Production Company
Lease Name Cargill "A" Well No. 1
Office Address Box 351, Liberal, Kansas 67901
Character of Well (completed as Oil, Gas or Dry Hole) Dry Hole
Date well completed November 10, 19 70
Application for plugging filed November 25, 19 70
Application for plugging approved November 12, 19 70
Plugging commenced November 10, 19 70
Plugging completed November 10, 19 70
Reason for abandonment of well or producing formation Dry Hole

If a producing well is abandoned, date of last production 19
Was permission obtained from the Conservation Division or its agents before plugging was commenced? Yes

Name of Conservation Agent who supervised plugging of this well G. R. Biberstein Attica, Kansas
Producing formation Depth to top Bottom Total Depth of Well 4715 Feet
Show depth and thickness of all water, oil and gas formations.

OIL, GAS OR WATER RECORDS

CASING RECORD

FORMATION	CONTENT	FROM	TO	SIZE	PUT IN	PULLED OUT
				8 5/8"	514'	NONE
RECEIVED STATE CORPORATION COMMISSION NOV 30 1970 CONSERVATION DIVISION Wichita, Kansas						

Describe in detail the manner in which the well was plugged, indicating where the mud fluid was placed and the method or methods used in introducing it into the hole. If cement or other plugs were used, state the character of same and depth placed, from feet to feet for each plug set.

Spotted 35 sacks cement from 450' to 350'.

Spotted 15 sacks cement from 45' to surface.

Hole filled with mud between plugs.

(If additional description is necessary, use BACK of this sheet)
Name of Plugging Contractor Bowers Drilling Company
Address Wichita, Kansas 67202

STATE OF KANSAS, COUNTY OF SEWARD, ss.
W. A. BEATTY (employee of owner) or (owner or operator) of the above-described

well, being first sworn on oath, says: That I have knowledge of the facts, statements, and matters herein contained and the log of the above-described well, and that the same are true and correct. So help me God.

(Signature) W. A. Beatty
W. A. BEATTY Ass't. to Superintendent

Subscribed AND SWORN to before me this 25 day of November, 19 70

My commission expires April 28, 1971

Notary Public.

DRILLER'S LOG

WELL NAME Cargill "A" No. 1 COMPANY OPERATING Anadarko Production Company
 ADDRESS OF COMPANY Box 351, Liberal, Kansas 67901
 WELL LOCATION $\frac{1}{4}$ $\frac{1}{4}$ $\frac{1}{4}$
3968 Ft. North of South Line,
1454 Ft. East of West Line, Sec. 27, Twp. 30S, Rge. 12W, Barber County, Kansas
 DRILLING STARTED 10-29, 19 70, DRILLING COMPLETED 11-10, 19 70
 WELL COMPLETED 11-10, 19 70, WELL CONNECTED _____, 19 _____
 ELEVATION 1769.0 Ft. Ground Level CHARACTER of WELL (Oil, Gas, Dry Hole) Dry Hole

OIL OR GAS SANDS OR ZONES - PERFORATIONS - ACIDIZING AND FRACTURING INFORMATION					
Name	From	To	No. of Shots	Gallons Used	Kind Used

RECEIVED
 STATE CORPORATION COMMISSION
 NOV 30 1970
 CONSERVATION DIVISION
 Wichita, Kansas

CASING RECORD

Size	Amount Set	Sacks of Cement	Amount Pulled
8 5/8	514		NONE

FORMATION RECORD

Formation	Top	Bottom	Formation	Top	Bottom
Sand	0	50			
Red Bed	50	236			
Red Bed & Shale	236	1003			
Shale	1003	1375			
Shale & Lime	1375	2103			
Lime	2103	2375			
Lime & Shale	2375	2945			
Lime	2945	3137			
Lime & Shale	3137	3845			
Lime	3845	4715			
Total Depth	4715				

RESULTS OF INITIAL PRODUCTION TEST: D & A