


Give All Information Completely
Make Required Affidavit
Mail or Deliver Report to:
Conservation Division
State Corporation Commission
212 No. Market
Wichita, Kansas

WELL PLUGGING RECORD

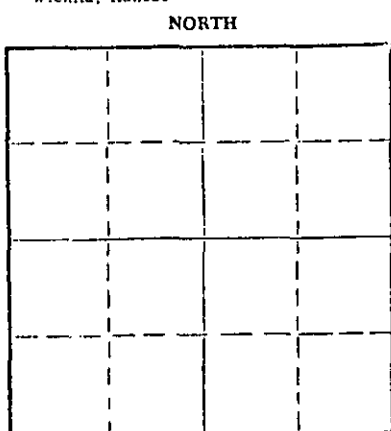

Harper County, Sec. 11 Twp. 33S Rge. (E) 7 (W)

Location as "NE/CNW/SW" or footage from lines 1980' FN&EL

Lease Owner Anadarko Production Company

Lease Name Terrell "A" Well No. 1

Office Address BOX 351, Liberal, Kansas 67901

Character of Well (completed as Oil, Gas or Dry Hole) Dry Hole

Date well completed February 14 19 74

Application for plugging filed February 14 (Verbally) 19 74

Application for plugging approved February 14 19 74

Plugging commenced February 14 19 74

Plugging completed February 14 19 74

Reason for abandonment of well or producing formation Dry Hole

If a producing well is abandoned, date of last production 19

Was permission obtained from the Conservation Division or its agents before plugging was commenced? Yes

Name of Conservation Agent who supervised plugging of this well G. Russell Biberstein, Attica, Ks. 67009

Producing formation Depth to top Bottom Total Depth of Well 4549 Feet

Show depth and thickness of all water, oil and gas formations.

OIL, GAS OR WATER RECORDS

CASING RECORD

FORMATION	CONTENT	FROM	TO	SIZE	PUT IN	PULLED OUT
				8-5/8"	312	None
				4-1/2"	4548	3843

Describe in detail the manner in which the well was plugged, indicating where the mud fluid was placed and the method or methods used in introducing it into the hole. If cement or other plugs were used, state the character of same and depth placed, from feet to feet for each plug set.

Ran free point & cut off 4-1/2" casing at 3843'. Pulled 4-1/2" casing to 320'. Spotted 40 sx cement 320' to 250'. Finished pulling 4-1/2" casing. Spotted 10 sx cement from 40' to 0'.

RECEIVED
STATE CORPORATION COMMISSION

MAR 18 1974


CONSERVATION DIVISION
Wichita, Kansas

(If additional description is necessary, use BACK of this sheet)

Name of Plugging Contractor Pratt Well Service, Inc.
Address Pratt, Kansas

STATE OF KANSAS, COUNTY OF SEWARD, ss.
J. W. Smith (employee of owner) or ~~owner or operator~~ of the above-described well, being first duly sworn on oath, says: That I have knowledge of the facts, statements, and matters herein contained and the log of the above-described well as filed and that the same are true and correct. So help me God.

(Signature) J.W. Smith
J.W. Smith, Division Prod. Engineer
Box 351, Liberal, Kansas 67901 (Address)

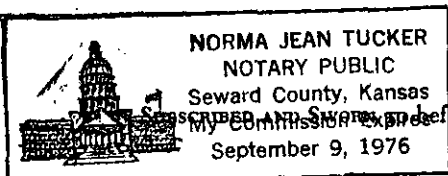

Subscribed and sworn to before me this 14th day of March, 1974.
Notary Public.

My commission expires

DRILLER'S LOG

WELL NAME Terrell "A" #1 COMPANY OPERATING Anadarko Production Company
 ADDRESS OF COMPANY Box 351, Liberal, Kansas 67901
 WELL LOCATION SW $\frac{1}{4}$ NE $\frac{1}{4}$ $\frac{1}{4}$
1980 Ft. ~~XXXXXX~~ From North Line
1980 Ft. ~~XXXXXX~~ Sec. 11, Twp. 33S, Rge. 7W, Harper County, Kansas
 From East Line
 DRILLING STARTED 1-21, 19 74, DRILLING COMPLETED 2-1, 1974
 WELL COMPLETED 2-14, 19 74, WELL CONNECTED _____, 19____
 ELEVATION 1366 Ft. Ground Level CHARACTER of WELL (Oil, Gas, Dry Hole) Dry Hole

OIL OR GAS SANDS OR ZONES - PERFORATIONS - ACIDIZING AND FRACTURING INFORMATION					
Name	From	To	No. of Shots	Gallons Used	Kind Used
Mississippian	4532	4540	16	Acidized w/500 gals	+ 15 BS.
"	4484	4502	32	Squeezed w/100 sx common.	Acidized w/2000 gallons + 30 BS.

CASING RECORD

Size	Amount Set	Sacks of Cement	Amount Pulled
8-5/8"	312'	300	None
4-1/2"	4548'	150	3843'

FORMATION RECORD

Formation	Top	Bottom	Formation	Top	Bottom
Red bed & shale	0	383			
Shale & lime	383	3615			
Stal. sand	3615	3735			
Lime & shale	3735	4022			
Lime	4022	4488			
Mississippian	4488	4549			
Total Depth	4549				

RECEIVED
 STATE CORPORATION COMMISSION
MAR 18 1974
 CONSERVATION DIVISION
 Wichita, Kansas

RESULTS OF INITIAL PRODUCTION TEST: _____

